


Section 12 Township 12 Range 18W
 Well No. 2 Jensen "D"
 Company Trans-Era

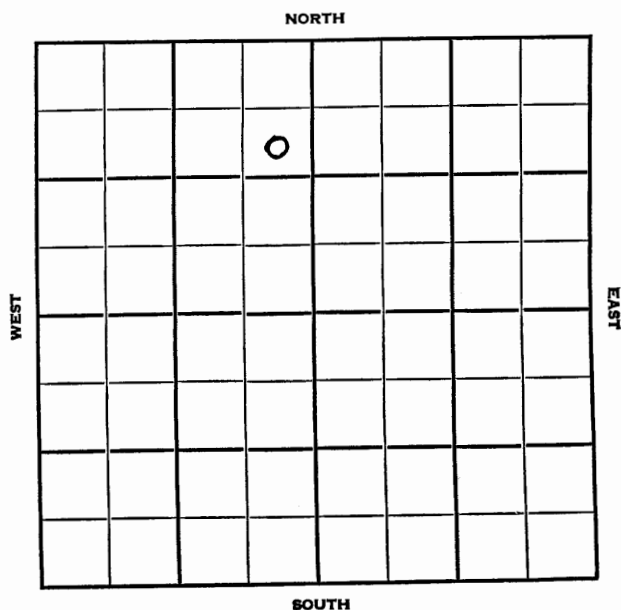

Ellis KANSAS

SEC.	TWP.	R.
12	12	18 W

WELL NO. # 2 Jensen "D" FARM

COMPANY Trans-Era

CONTRACTOR

Walter Pool


990 Ft. from N. Line

Ft. from S. Line

330 Ft. from E. Line

Ft. from W. Line

SE NE NW

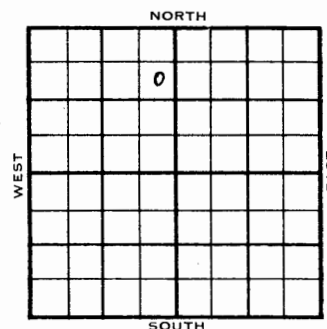

	ELEVATION	REPORT
1954	2102'	
10/20	Spud 10-18-54 8" @ 203 Drlg. 490'	
11/3	Spud 10-18-54 D & A TD 3664' 8" @ 203' Heeb 3316', Lans 3361', DST 3400'-70' opn 1 hr, rec 30' Mud 650# Arb. 3648' DST 3649'-54' opn 1 hr, rec 10' Mud 90# TD 3664' D & A	
		ABANDONED

County	Ellis		State	Kansas	
Sec.	12	(Blk. Twp.)	12	(Sur. Rge.)	18W Map No.
Operator	Trans-Era				
Well No.	2	Farm	Jensen "D"		
Elev.	2102	Location	SE NE NW		
			990 Ft. From	N Line	NW
			330 Ft. From	E Line	Quarter
			1st. Report		
			Completion	NOV 3 1954	
			Remarks	Walter Pool	
Spudding Date			10-18-54		
Drlg. Data			D & A TD 3664		
8" © 203 Heeb. 3316 Lans. 3361					

FABEN GILSTRAP