


Section 12 Township 2 Range 18W

Well No. 3 Jensen "D"

Company Trans-Era Pet.

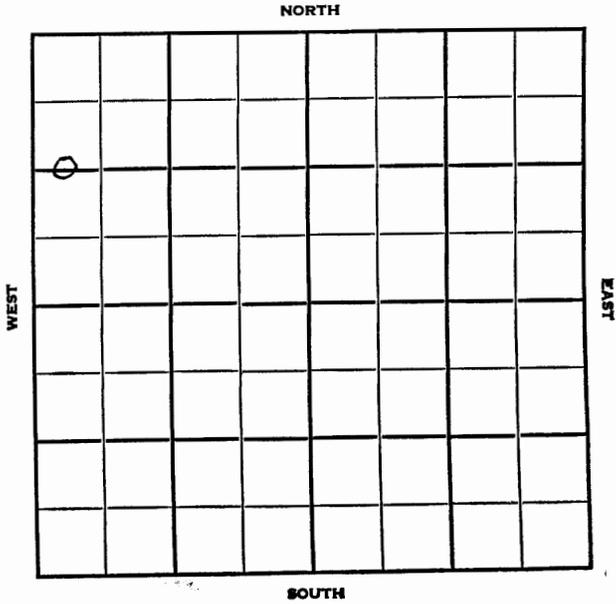


Ellis

SEC. 12	TWP. 12	R. 18W
---------	---------	--------

WELL NO. #3 Jensen "D" FARM

COMPANY Trans-Era Pet.

CONTRACTOR Co. Tools Walters

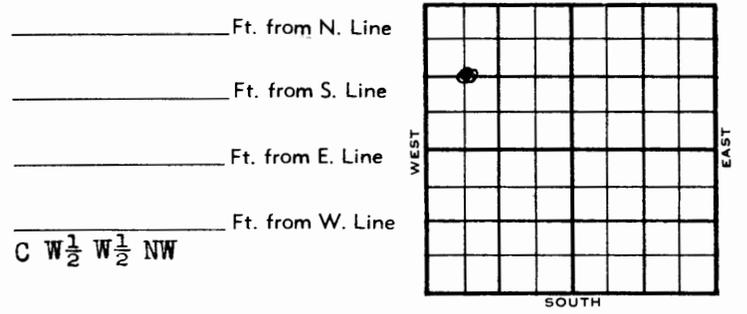

	ELEVATION	REPORT
1955	2104'	
7/20	Comm 7-14-55 10" @ 203/240 Drlg: 2625	
8/4	Comm 7-14-55 H 3317, L 3362, C 3616 TD 3660 10" @ 203/240 EST 212-214-215 DST 3435-64 open 1 hr Rec 40' mud D & A	
ABANDONED		

County **Ellis** Elev. **18W**
 Sec. **12** Twp. **12** Rge. **18W**
 Company **Trans-Era Pet.**
 FarmName **Jensen "D"** No. **3**

TOPS	DEPTH	LOG	DATUM	Loc. in Sec.				
Anh.				C W $\frac{1}{2}$ W $\frac{1}{2}$ NW				
TP.								
H.								
Tr.								
Dg.								
Bl.								
L.								
K.C.								
B.K.C.								
Ce.								
C.				Geol.				
M.				Contr.				
M.				Co. tools				
K.				Pool				
Mz.				Walters				
Me.				<table border="1"> <tr> <td>0</td> <td>JUL 20 55</td> </tr> <tr> <td colspan="2" style="text-align: center;">FIRST REPORT</td> </tr> </table>	0	JUL 20 55	FIRST REPORT	
0	JUL 20 55							
FIRST REPORT								
V.								
S.								
A.								
R.								
Pe.								
G.								
TD.								

Date Comm. **7-14-55**
10" @ 205/240 drlg. 2625

County **Ellis** Elev. **2104**
 Sec. **12** Twp. **22** Rge. **18W**
 Company **Trans-Era Pet.**
 FarmName **Jensen "D"** No. **3**

TOPS	DEPTH	LOG	DATUM	Loc. in Sec.				
Anh.				C W $\frac{1}{2}$ W $\frac{1}{2}$ NW				
TP.								
H.	3317		1213					
Tr.								
Dg.								
Bl.								
L.	3362		1258					
K.C.								
B.K.C.								
Ce.								
C.	3616		1512	Geol.				
M.				Contr.				
M.				Co. tools				
K.				Pool				
Mz.				Walters				
Me.				<table border="1"> <tr> <td>0</td> <td></td> </tr> <tr> <td colspan="2" style="text-align: center;">ABANDONED</td> </tr> </table>	0		ABANDONED	
0								
ABANDONED								
V.								
S.								
A.								
R.								
Pe.								
G.								
TD.	3660							

Date Comm. **7-14-55** **AUG 3 1955**
10" @ 203/240 DST 3435-64 open 1 hr.
Rec. 40' mud

D & A

2460
 2460
 2460