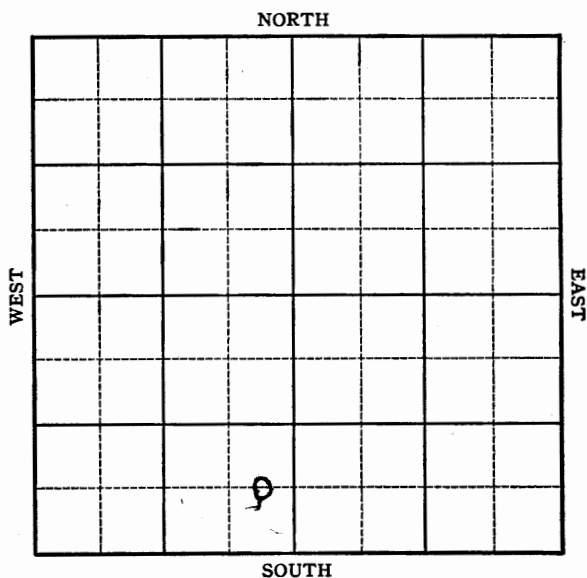



KANSAS

Ellis County

KANSAS Ellis County

Sec. 12 Twp. 12 R. 18-WWell No. #4 Jensen A Farm _____Aylward Prod Company _____Section 12 Township 12 Range 18WWell No. #4 Jensen "A"Company Aylward Prod.

_____ Ft. from N. Line

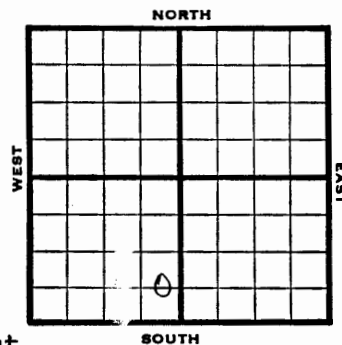660 Ft. from S. Line330 Ft. from E. Line290 Ft. from W. Line

CES SE SW Glathart

1946 Elev. 2149 REPORT

6/19 Location

6/26 8" @ 1390' WOC

7/3 Anny 1385'
Topeka 3358'
Lans 3404'

Drlg 3577 SO

7/9 Cong 3638 Simp 3662
Arb 3681
8184 TD
5" @ 3682 RUST7/16 TD 3690
Plug 3670
78 shots 3488 to 36387/24 Arb. 3681
5" @ 3682
TD 3690'

ABANDONED

KANSAS Pool Name Glatthart
 Map No. 71 Sec. 12 Twp. 12 R. 18W
 Well No. 4 Jensen "A"

Aylward Prod. Company

FIRST REPORT

Contractor

C E L SE SW

SECTION PLAT

 Ft. from N. Line
660 Ft. from S. Line
 Ft. from E. Line
990 Ft. from W. Line

Ellis County

Location X

RECORD

Cased in., ft.
 Sand
 Gas
 Oil
 Total Depth

PRODUCTION

1st 24 hrs. Nat.
 1st 24 hrs. after shot
 Gas Cu. Ft.
 Dry Hole
 Abandoned

Date

JUN 19 1946 19 S. J. LEWIS Scout

KANSAS Pool Name Glatthart Pool
 Map No. 71 Sec. 12 Twp. 12 R. 18W
 Well No. 4 Jansen "A"

Aylward Prod. Company

ABANDONED

Contractor

C E L SE SW

SECTION PLAT

 Ft. from N. Line
660 Ft. from S. Line
330 Ft. from E. Line
 Ft. from W. Line

Ellis County

Location

RECORD

Cased in., ft.
 Sand
 Gas
 Oil
 Total Depth 3690

PRODUCTION

1st 24 hrs. Nat.
 1st 24 hrs. after shot
 Gas Cu. Ft.
 Dry Hole
 Abandoned

Date

JUL 24 1946 19 S. J. LEWIS Scout

KANSAS

Pool Name Glathart

Map No. _____ Sec. 12 Twp. 12 R. 18W

Well No. 4 Jensen "A"

Aylward Prod. Company

CORRECTION Contractor

C E L SE SW

SECTION PLAT

_____ Ft. from N. Line

660 Ft. from S. Line

330 Ft. from E. Line

_____ Ft. from W. Line

Ellis County

Location _____

Rig up _____

Drilling and Remarks:

Had 660 S line
990 W line

RECORD

Cased _____ in, _____ ft.

Sand _____

Gas _____

Oil _____

Total Depth _____

PRODUCTION

1st 24 hrs. Nat. _____

1st 24 hrs. after shot _____

Gas _____ Cu. Ft.

Dry Hole _____

Abandoned _____

Date

JUN 19 1946

19

S. J. LEWIS

Scout