

KANSAS Ellis county**KANSAS**

Ellis County

Sec. 12 Twp. 12 R. 18WWell No. #4 ~~#3~~ Jensen "B" Farm

Aylward Prod. Company

Koblitz


Ft. from N. Line

330 Ft. from S. Line


Ft. from E. Line

330 Ft. from W. Line

SW SE

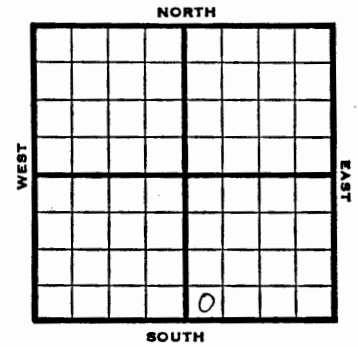

NORTH

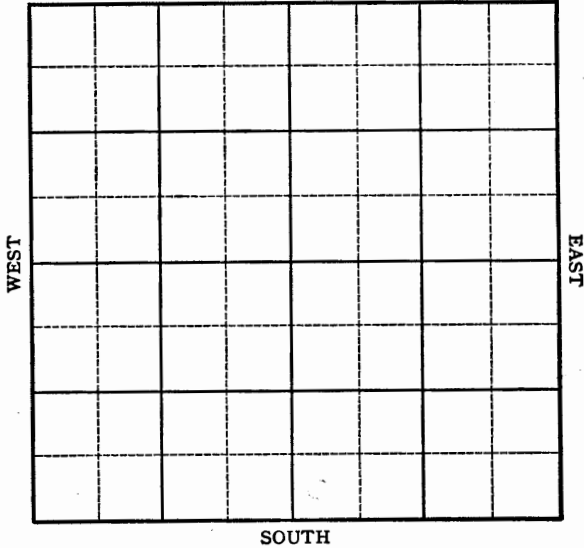

SOUTH

1946 Elev. 2165 REPORT

5/1 Location
 5/7 8" @ 1415 WOC
 5/14 Anhy 1415
 Dodge 3382
 Lans 3411
 Drlg 3465'
 5/21 Ard 3674-5" @ 3674
 TD 3678-1800' oil 1½ hrs.
 5/29 " " " "
 6/5 Arb. 3674
 5" @ 3674
 TD 3678
 Pump 370 Pot.
 Grav. 25.0

COMPLETED

KANSAS

Kansas Pool Name

Koblitz

Map No. 7/ Sec. 12 Twp. 12 R. 18WWell No. 3 Jensen "B"

Aylward Prod.

Company

FIRST REPORT

Contractor

SW SE

SECTION PLAT

		0	

Ft. from N. Line

330 Ft. from S. Line

Ft. from E. Line

330 Ft. from W. Line

Ellis County

Location X

Rig up

Drilling and Remarks:

RECORD

Cased in., ft.Sand Gas Oil Total Depth

PRODUCTION

1st 24 hrs. Nat. 1st 24 hrs. after shot Gas Cu. Ft.Dry Hole Abandoned

Date

MAY 1 1946 19S. J. LEWIS Scout

KANSAS

Kansas Pool Name

Koblitz

Map No. 7/ Sec. 12 Twp. 12 R. 18WWell No. 4 Jensen "B"

Aylward Prod.

Company

CORRECTION

Contractor

SW SE

SECTION PLAT

		0	

Ft. from N. Line

330 Ft. from S. Line

Ft. from E. Line

330 Ft. from W. Line

Ellis County

Location Rig up

Drilling and Remarks:

Reported as

#3 Jensen "B"

RECORD

Cased in., ft.Sand Gas Oil Total Depth

PRODUCTION

1st 24 hrs. Nat. 1st 24 hrs. after shot Gas Cu. Ft.Dry Hole Abandoned

Date

MAY 15 1946 19S. J. LEWIS Scout

KANSAS Kansas Pool Name Koblitz Pool
 Map No. 71 Sec. 12 Twp. 12 R. 18W
 Well No. 4 Jensen "B"

Aylward Prod. Company

COMPLETED

Contractor

SW SE

E12165


SECTION PLAT

 Ft. from N. Line

330 Ft. from S. Line

 Ft. from E. Line

330 Ft. from W. Line

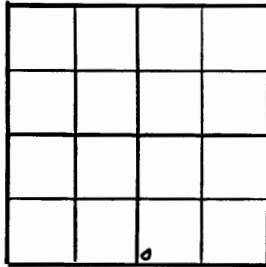

Ellis County

Location

Rig up

Drilling and Remarks:

Per 3674

5" @ 3674

Pray 370 ft.

25-5 ft

RECORD

Cased in., ft.

Sand

Gas

Oil

Total Depth 3625

PRODUCTION

1st 24 hrs. Nat.

1st 24 hrs. after shot

Gas Cu. Ft.

Dry Hole

Abandoned

Date

JUN 5 1946 19 S. J. LEWIS Scout