

Sec. 12 Twp. 12 R. 18W

Section 12 Township 12 Range 18W

Well No. 1 Jensen "B"

Company Aylward etal

Well No. 1 Jensen "B" Farm _____

Aylward etal Company _____


Glathart

_____ Ft. from N. Line


330 Ft. from S. Line

330
990 Ft. from E. Line

_____ Ft. from W. Line

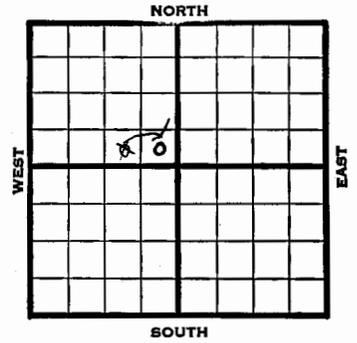

~~SW SE NW~~ Elev. 2105

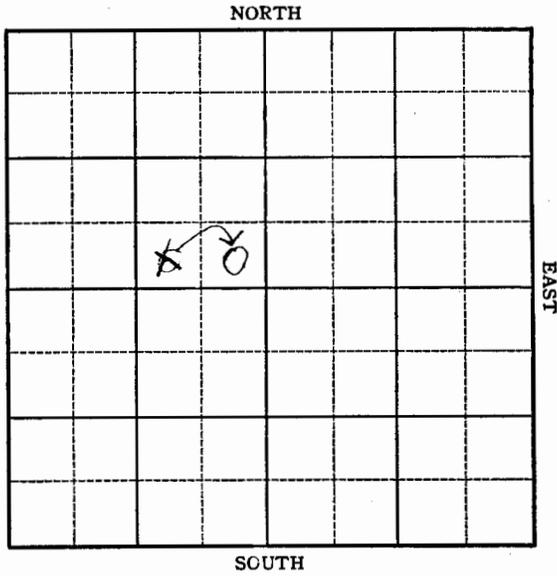

1945		REPORT			
6/13	Location				
6/21	"				
6/28	"				
7/3	RUR				
7/11	8" @ 1370				
	Drlg. 2200'				
7/19	Anhy 1360				
	Drlg. 3470'				
7/26	Lans 3358				
	Arb. 3625				
	TD 3630				
	5" @ 3627'	swab	20	oil	per hr.
8/1	"	"	"	"	"
8/8	"	"	"	"	"
8/15	"	"	"	"	"
8/22	Arb. 3625				
	5" @ 3627				
	TD 3630				
	Pump 200 Pot.				
	Grav. 28.9				

COMPLETED

KANSAS Kansas Pool Name Glathart

Map No. 71 Sec. 12 Twp. 12 R. 18W

Well No. 1 Jensen "B"

Aylward etal Company

CORRECTION Contractor

SE NW


SECTION PLAT

Ft. from N. Line

330 Ft. from S. Line

330 Ft. from E. Line

Ft. from W. Line

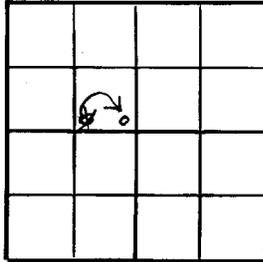

Ellis County

Location

Rig up

Drilling and Remarks: reported SW SE NW

RECORD

Cased in. ft.

Sand

Gas

Oil

Total Depth

PRODUCTION

1st 24 hrs. Nat.

1st 24 hrs. after shot

Gas Cu. Ft.

Dry Hole

Abandoned

Date

JUL 3 1945 19 S. J. LEWIS Scout

Kansas Pool Name Glathart

Map No. 71 Sec. 12 Twp. 12 R. 18W

Well No. 1 Jensen "B"

Aylward etal Company

FIRST REPORT Contractor

SW SE NW


SECTION PLAT

Ft. from N. Line

330 Ft. from S. Line

990 Ft. from E. Line

Ft. from W. Line

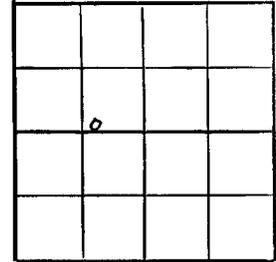

Ellis County

Location X

Rig up

Drilling and Remarks:

RECORD

Cased in. ft.

Sand

Gas

Oil

Total Depth

PRODUCTION

1st 24 hrs. Nat.

1st 24 hrs. after shot

Gas Cu. Ft.

Dry Hole

Abandoned

Date

JUN 13 1945 19 S. J. LEWIS Scout

KANSAS

Kansas Pool Name Glatthart

Map No. 71 Sec. 12 Twp. 12 R. 18W

Well No. 1 Jensen "B"

Aylward etal Company

COMPLETED Contractor

SE NW

E/2105

SECTION PLAT

 Ft. from N. Line

330 Ft. from S. Line

330 Ft. from E. Line

 Ft. from W. Line

Ellis County

Location

Rig up

Drilling and Remarks:

Co #3625-

5" O3627

Pump 200 Pst

2829

RECORD

Cased in., ft.

Sand

Gas

Oil

Total Depth 3620

PRODUCTION

1st 24 hrs. Nat.

1st 24 hrs. after shot

Gas Cu. Ft.

Dry Hole

Abandoned

Date

AUG 22 1945

19

S. J. LEWIS

Scout