


SECTION 12 TOWNSHIP 12 RANGE 18W
 WELL NO. #2 Jensen "F"
 COMPANY Weaver & Sierra

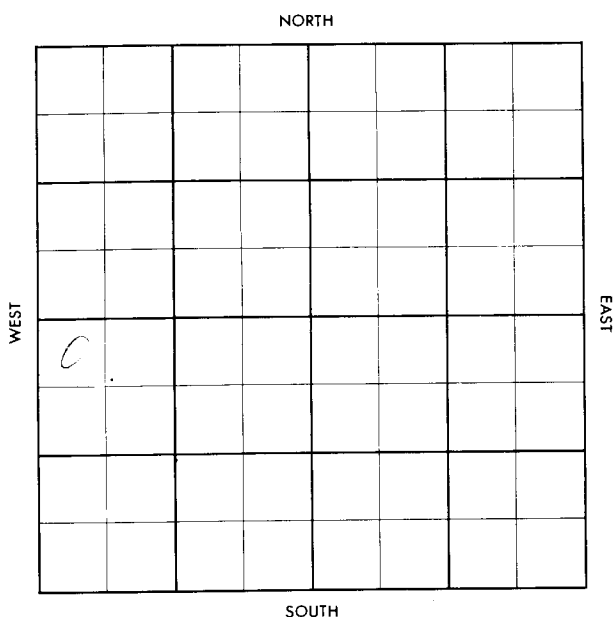

Ellis KANSAS

SEC. 12 TWP. 12 R. 18W
 WELL NO. #2 Jensen "F" FARM
 COMPANY Weaver & Sierra
 CONTRACTOR

Co. Tools

Walter


Ft. from N. Line

Ft. from S. Line

Ft. from E. Line

Ft. from W. Line

NW NW SW

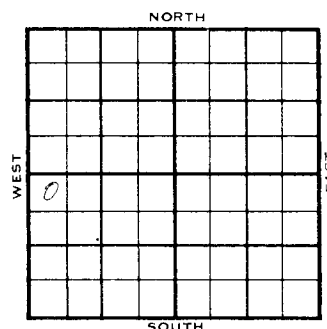

1956	ELEVATION	REPORT
	2096'	
5-16	8" @ 210 w/135 Drlg. 3297'	
6-6	DST 3376-92 op 1 hr. rec. 80' MSW, BHP 380/20" DST 3411-43 op 30 min. rec. 25' mud, BHP 580/20" 5 1/2" @ 3617 w/75 CO 3618 B/ 5 3/4 BF, no time FU 1100' wtr / scum, 8 hrs. DD 3620, FU 1350' wtr, 8 hrs. DD 3623 S/ 5 3/4 BW / tr. oil PB 3570 Pf. 24/ 3420-26 S/ 4 1/2 BW, A 2500 FU 1100' FL/12 hrs. 20% oil PB 3398 Pf. 30/3371-80 S/ 31 gw, 5 go, 1 hr., A-500 S/ 3 BFPH, 25% wtr., A 2500 FU 750' FL/ 12 hrs., 85% wtr. D & A Anh. 1340', H. 3301', Tr. 3321', L. 3348', S. 3597', A. 3615'. TD 3618'.	

DX-78

ABANDONED

FORM 513 SUNRAY

County	Ellis	Elev.	2096
Sec.	12	Twp.	12
Company	Weaver & Sierra	Rge.	18W
Farm Name	Jensen "F"	No.	2

TOPS	DEPTH	LOG	DATUM	Loc. in Sec.
Anh.	1340			NW NW SW
Tr.	3301			
Dg.	3321			
Bl.				230' WL
L.	3348			Geol.
K.C.				Contr.
B.K.C.				Co. tools
Ce.				Pool
C.				Walter
M.				
M.				
K.				
Mr.				
Me.				
V.				
S.	3597			
S.				
A.	3615			
R.				
PE.				
G.				
TD.	3618			ABANDONED

Date Comm. JUN 6 1956

8" @ 210/135 drls. 3297 MAY 23 '56

DST 3376-92 1hr 80' MSW BHP

380/20" DST 3411-43 30" MSW

25' Md BHP 550/20 5 1/2 @ 3617

175 MICT MAY 29 '56 CO 3618 @ 5 3/4

BF no time FU 1100' wtr + scum

8 hrs DD 3620 FU 1350' wtr 8

hrs DD 3623 @ 5 3/4 BW + Tr. oil

SD W.O.O. JUN 6 '56 PB 3570 pf 24

3420-26 @ 4 1/4 BW A 2500

FORM 513-1 SUNRAY

Jensen "F" #2

12-12-18W Weaver & Sierra

FU 1100' FI 112 hrs

20% O.I. PB 3328

PT 30/3371-80 @ 31 1/2 W

5 gals/hr A 500 @ 38 BHP

25% W A 2500 FU 750' FI

112 hrs 85% wtr

D & A

County	El 146	Elev.	2096
Sec.	12	Temp.	12
Company	Wester & Sierra		
Farm Name	Jensen NFM	No.	2

TOPS	DEPTH	LOG	DATUM	Loc. in Sec.
Anh.				NW NW SW
Tr.				
H.				
Tr.				
Dg.				230' WL
BL.				
L.				Geol.
K.C.				Contr.
BKC.				Co. tools
Ce.				
C.				Pool
M.				Walter
M.				
K.				
Mz.				
Me.				
V.				
S.				
S.				
A.				
R.				
PE.				
G.				
TD.				

Date Comm. **8" @ 210/135 drlg. 3297**

FIRST REPORT

MAY 16 '56