

ELLIS

KANSAS

12

12S

18W

SECTION TOWNSHIP RANGE


#2 Joy "B"

WELL NO.

Sierra Petroleum

COMPANY

NORTH

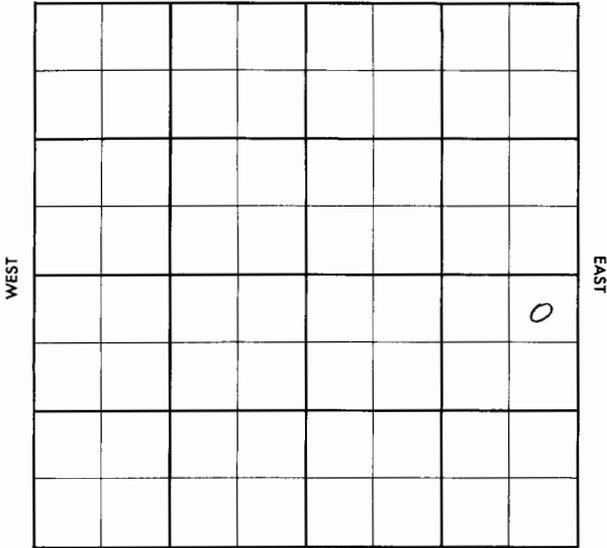

SOUTH

SEC.	TWP.	R.
12	12S	18W

WELL NO.

2 Joy "B"

FARM

COMPANY

Sierra Petroleum

CONTRACTOR

Walter

FT. FROM N. LINE


FT. FROM S. LINE

FT. FROM E. LINE

FT. FROM W. LINE

NE NE SE

NORTH

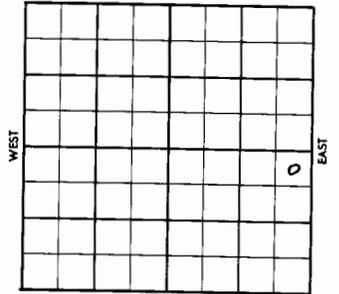

SOUTH

1956	ELEVATION	REPORT
	2173'	

6-20 Loc.  
 8-15 Comm. 6-24-56  
 8 5/8" @ 203 w/140  
 DST 3431-70 op 1 hr., rec. 1200' GCO,  
 BHP500/20".  
 5 1/2" @ 3690 w/125  
 DST 3420-3515 op 1 hr., rec. 220' cil,  
 & GCM / 840' gas / 50' wtr., BHP 525/20  
 CO 3699  
 FU 125' oil / tr. wtr., 12 hrs.  
 S/ 2 1/2 boph, no/wtr., 6 hrs.  
 PB 3600; 24/3494-3500; 36/3505-14;  
 FU 1600' fluid, 6 hrs.  
 S/ av. 50 bfph, 21% wtr., 3 hrs.  
 PB 3480; 40/3442-52  
 FU 1100' fluid, 2 hrs.  
 S/ av. 50 bfph, 20% wtr., 2 hrs.  
 CO 3600  
 P/ 100 bopd, / 20% wtr.  
 Anh. 1375'; H. 3371'; L. 3416'; S. 3666'  
 A. 3695';  
 TD 3699'

COMPLETED

FORM 504-B SUNRAY

FORM 504-3 SUNRAY



County ETWAS Elev. 2173  
 Sec. 12 Twp. 12S Rge. 10W  
 Company Sierra Petroleum  
 Farm Name Joy #2 No. 2

TOPS	DEPTH	LOG	DATUM	Loc. in Sec.
Anh.	1375			NE NE SE
Tp.				
H.	3371			
Tr.				
Dg.				
Bl.				
L.	3416			Geol.
M.C.				Contr.
B.K.C.				
Ce.				
C.				
M.				Pool
M.				Water
K.				
Mz.				
Mo.				
V.	3426			COMPLETE
S.				
S.	3495			
A.				
R.				
Pe.				
G.				
To	3699			AUG 15 '56

Date Comm. JUN 27 '56 6-24-56 8 5/8  
203/140 WOC JUL 3 '56 DST 3431  
-70 1hr 1200' GC oil BHT  
500/120" IP 3515 JUL 11 '56 5 1/2 @  
3690/125 DST 3420-3515  
1hr see 220' oil & GCM + 840'  
Gas + 50' wt BHT 525/20  
JUL 18 '56 WOC JUL 25 '56 CO 3699 FU  
125' oil + Tr. wtr 12 hrs @ 2 1/2  
Boek no/w 6 hrs @ 1 1/2 AUG '56  
AUG 8 '56 AUG 15 '56

Co.  
Lse.  
No.  
Sec.  
T.  
R.

PB 3600 24/3494-3500 34/  
 3505-14 1/2" FU 1600 Fluid  
 6 hrs 5 AV, 50 BFR 21%  
 wta 3 hrs. PB 3480 40/  
 3442-52 FU 1100 Fluid 2 hrs  
 5 AV 50 BFR 20% wta  
 2 hrs 60 3599 POP  
 AUG 6 30 3600 TGR  
 AUG 10 35 P. 100 Bofid + 20%  
 wta

12-12-11 NE NE SE