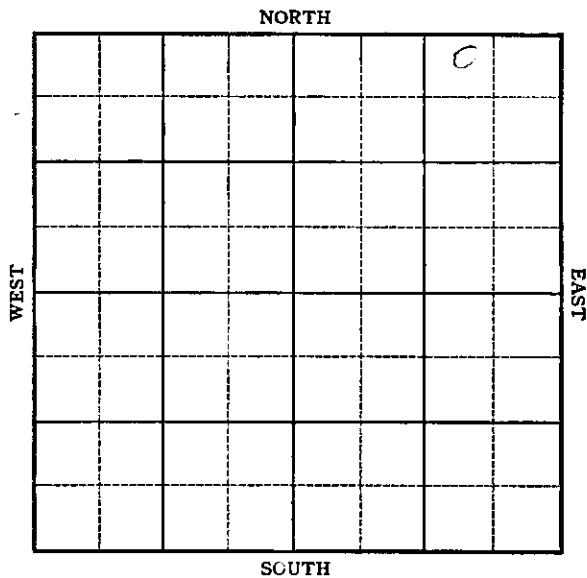


KANSAS

Ellis County

FORM 51 5M 11-44 PETROL

Section 12 Township 12 Range 18WWell No. 2 KarlinCompany Aylward etal

FORM 51 5M 11-44 PETROL

KANSAS

Ellis

Sec. 12 Twp. 12 R. 18WWell No. 2 Karlin FarmAylward etal Company


Glathart

330 Ft. from N. Line

Ft. from S. Line

990 Ft. from E. Line

Ft. from W. Line

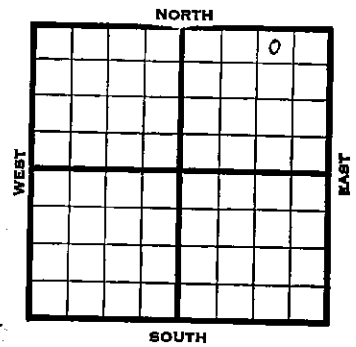NW NE NE 41-0.5 130

1945

REPORT

6/13

Berrick

6/21

8" @ 1360

Anhy 1335

Drlg. 2103

7/3

Lens 3388

Cong 3656

TD 3696'

ABANDONED

KANSAS

Kansas Pool Name GlathartMap No. 71 Sec. 12 Twp. 12 R. 18WWell No. 2 Karlin "B"Aylward etal CompanyABANDONED Contractor

NW NE NE

SECTION PLAT

330 Ft. from N. Line Ft. from S. Line990 Ft. from E. Line Ft. from W. Line

			a

Ellis County

Location

Rig up

Drilling and Remarks:

Line 3388Cong 9656

RECORD

Cased in., ft.Sand Gas Oil Total Depth 9656

PRODUCTION

1st 24 hrs. Nat. 1st 24 hrs. after shot Gas Cu. Ft.Dry Hole Abandoned

Date

JUL 3 1945 19S. J. LEWIS ScoutKansas Pool Name GlathartMap No. 71 Sec. 12 Twp. 12 R. 18WWell No. 2 KarlinAylward etal CompanyFIRST REPORT Contractor

NW NE NE

SECTION PLAT

330 Ft. from N. Line Ft. from S. Line990 Ft. from E. Line Ft. from W. Line

			b

Ellis County

Location

Rig up

Drilling and Remarks:

derrick

RECORD

Cased in., ft.Sand Gas Oil Total Depth

PRODUCTION

1st 24 hrs. Nat. 1st 24 hrs. after shot Gas Cu. Ft.Dry Hole Abandoned

Date

JUN 13 1945 19S. J. LEWIS Scout