

Section 12 Township 12 Range 18W

Well No. 2 #1 Karlin "B"


Company Trans-Era

SEC. 12 TWP. 12 R. 18W  
 WELL NO. 2 #1 Karlin "B" FARM


COMPANY Trans-Era

CONTRACTOR B & R Drlg.  
Walter Pool

330 Ft. from N. Line  
990 Ft. from S. Line  
 Ft. from E. Line  
 Ft. from W. Line

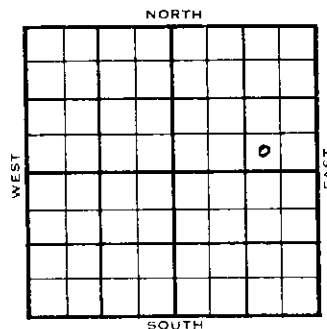

SW SE NE

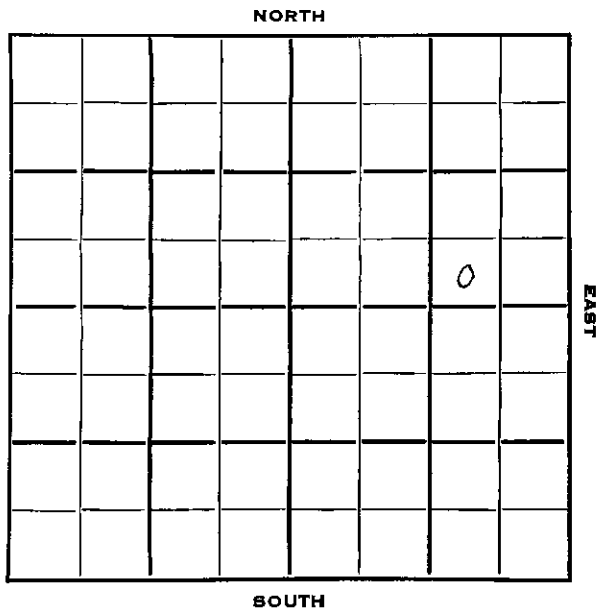

	ELEVATION	REPORT
1953	2167'	
12/30	RUR	
1954		
1/6	8" @ 187 Drlg. 3361'	
1/13	Heeb 3369' KC 3414' Arb. 3695' TD 3698' 5" @ 3696 DST 3423-85, 1 hr, 150' O & GCM 375# DST 3485-3518', 1 hr, gas in 30", 300' SW, 200' O & WCM 880#	
1/20	DD 3699' TD S/6 boph 14 hrs.	
1/27	500 A S/7 BOPH	
2/3	NR	
2/10	NR	
2/24	Spud 12-29-53 Oil Well TD 3699' 8" @ 187' Heeb 3369', KC 3414', Arb. 3695' TD 3698' 5" @ 3696' DST 3423-85', opn 1 hr., rec. 150' g & ocm, 375# DST 3485-3518', opn 1 hr., gas in 30 mins., rec. 300' SW, 200' o&wcm	

DX-78

OVER

523623

1954 (Information brought Forward)

2/24

880#

DD 3699\*

S/6 boph 14 hrs., k 500A

S/7 boph P/70 bopd

Comp. 25 bopd

**COMPLETED**

---



Map No. \_\_\_\_\_ Sec. 12 Twp. 12 R. 18W

Well No. 2 Karlin "B"

Trans-Era Pet. \_\_\_\_\_ Company

CORRECTION \_\_\_\_\_ Contractor

SW SE NE

SECTION PLAT

			o

\_\_\_\_\_ Ft. from N. Line

330 Ft. from S. Line

990 Ft. from E. Line

\_\_\_\_\_ Ft. from W. Line

Ellis County

Location \_\_\_\_\_

Rig up \_\_\_\_\_

Drilling and Remarks:

Reported  
#1 Karlin

RECORD

Cased \_\_\_\_\_ in., \_\_\_\_\_ ft.

Sand \_\_\_\_\_

Gas \_\_\_\_\_

Oil \_\_\_\_\_

Total Depth \_\_\_\_\_

PRODUCTION

1st 24 hrs. Nat. \_\_\_\_\_

1st 24 hrs. after shot \_\_\_\_\_

Gas \_\_\_\_\_ Cu. Ft.

Dry Hole \_\_\_\_\_

Abandoned \_\_\_\_\_

Date

JAN 2 1919

J. G. McGENEE Scout