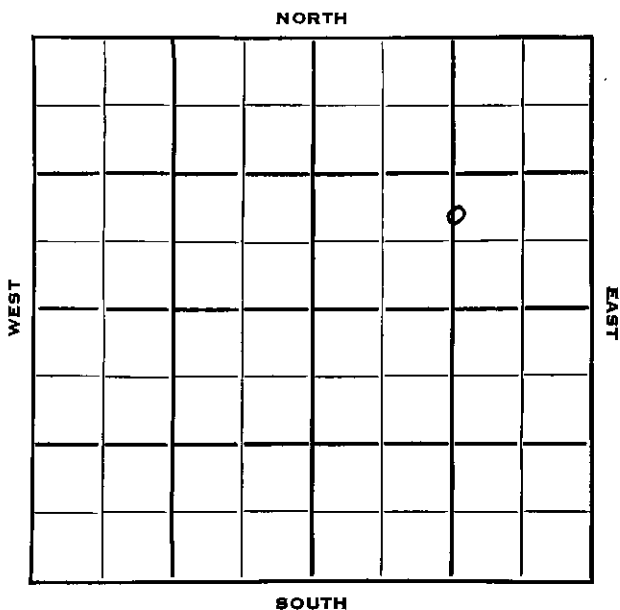


Section 12 Township 12 Range 18WWell No. 3 Karlin "B"Company Trans-Era Petr.

SEC.	TWP.	R.
12	12	18W

WELL NO.

#3 Karlin "B"

FARM

COMPANY

Trans-Era Pet.

CONTRACTOR

Trans Era.

Walter Pool

Ft. from N. Line


900

Ft. from S. Line

1300

Ft. from E. Line

Ft. from W. Line

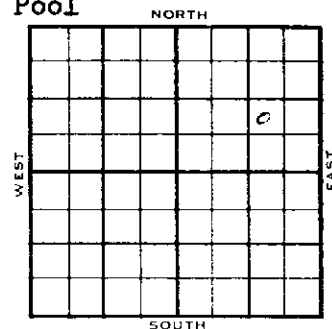

NW SE NE

1954

ELEVATION

2138'

REPORT

4/21

Spud 4-16-54

8" @ 185'

Drilg 2416'

6/2

Spud 4-16-54

Oil Well

TD 3674'

8" @ 185'

Heeb 3347', Mans 3392', B KC 3618',

Cong 3639', Simp 3653', Simp Dol 3659',

Arb. 3672'

TD 3674'

5" @ 3673'

CO to 3674

45 goph 500A

S/2 boph 1000A

S/2 1/2 boph 1500A

2 boph

Sd-oil-frac 4 boph

Comp. 50bopd

COMPLETED

County	Ellis	State	Kansas
Sec.	12 (Blk. Twp.)	12 (Sur. Rge.)	18W Map No.
Operator	Trans-Era Pet.		
Well No.	3	Farm	Karlin "B"
Elev.	2138	Location	NW SE NE
900 Ft. From S Line		NE	
1300 Ft. From E Line		Quarter	
1st. Report			
Completion		JUN 2 1954	
Remarks		Walter Pool	
		Trans-Era - Contr.	
Spudding Date		4-16-54	

Drilg. Data Oil well TD 3674

8" @ 185 Heeb. 3347 Lans. 3392

2 XC 3618 Cong. 3639 Simp. 3653

Simp. del. 3659 Arb. 3672 TD 3674

5" @ 3673 CO to 3674 45 goph 500 A

S/ 2 boph 1000 A S/ 2 1/2 boph 1500 A

2 boph sd-oil-frac 4 boph

Comp. 50 bopd

J. G. McGEHEE

County	Ellis	State	Kansas
Sec.	12 (Blk. Twp.)	12 (Sur. Rge.)	18W Map No.
Operator	Trans-Era Pet.		
Well No.	3	Farm	Karlin "B"
Elev.	2138	Location	NW SE NE
900 Ft. From S Line		NE	
1300 Ft. From E Line		Quarter	
1st. Report		APR 21 1954	
Completion			
Remarks		Trans-Era - Contr.	
Spudding Date		4-16-54	

Drilg. Data Walter Pool

8" @ 185 drlg. 2416

J. G. McGEHEE