

KANSAS

Ellis

KANSAS ✓

Ellis

FORM 252-B

Sec. 12 Township 12 Range 18W

Section 12 Township 12 Range 18W


Well No. 1 Karlin ~~and~~ B

Well No. #1 Karlin "D" B Farm

Company Trans-Era

Trans-Era Company

NORTH

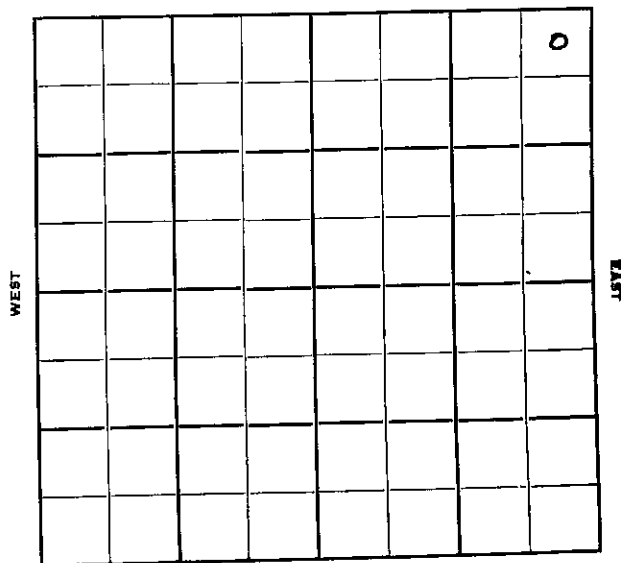

SOUTH

Bemis Pool

Contractor

330 Ft. from N. Line


Ft. from S. Line

330 Ft. from E. Line

Ft. from W. Line

NE NE NE

NORTH

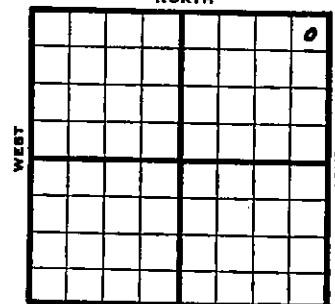

SOUTH

1953 Elev. 2105' REPORT

1/21 Spud 1-18-53
8" @ 1881/29 Anhy 1335
Drlg. 3253'2/4 Spud 1-18-53
D & A TD 3682' 8" @ 188
Anhy 1335' Heeb 3320' Lans 3365'
Arb. 3665'
TD 3682' D & A

ABANDONED

County	Ellis			State	Kansas		
Sec.	12	(Bk. Twp.)	12	(Sur. Rge.)	18W	Map No.	
Operator	Trans-Era						
Well No.	1	Farm	Karlin "D"				
Elev.				Location	NE NE NE		
				330 Ft. From	N Line	NE	
				330 Ft. From	E Line	Quarter	
				1st. Report	JAN 21 1953		
				Completion			
				Remarks			
Spudding Date				1-18-53			
Orig. Data	Bemis Pool						
8" @ 188							

J. G. McGEHEE

County	Ellis			State	Kansas		
Sec.	12	(Bk. Twp.)	12	(Sur. Rge.)	18W	Map No.	
Operator	Trans-Era						
Well No.	1	Farm	Karlin "D"				
Elev.	2105			Location	NE NE NE		
				330 Ft. From	N Line	NE	
				330 Ft. From	E Line	Quarter	
				1st. Report	FEB 4 1953		
				Completion			
				Remarks	Bemis Pool		
Spudding Date				1-18-53			
Orig. Data	D & A TD 3682						
8" @ 188 Anhy 1335 Heeb. 3320							
Lens. 3365 Arb. 3665 TD 3682							
D & A							

J. G. McGEHEE