

Ellis

KANSAS

Section 13 Township 12 Range 18-WWell No. #1 A. E. KarlinCompany Gulf Oil

FORM 252-A 5M 10-38 KANSAS

Ellis

Sec. 13 Twp. 12 R. 18-WWell No. #1 A. E. Karlin Farm

Gulf Oil

Company

(Walters)



330 Ft. from N. Line

Ft. from S. Line

990 Ft. from E. Line

Ft. from W. Line

Elev. 2185

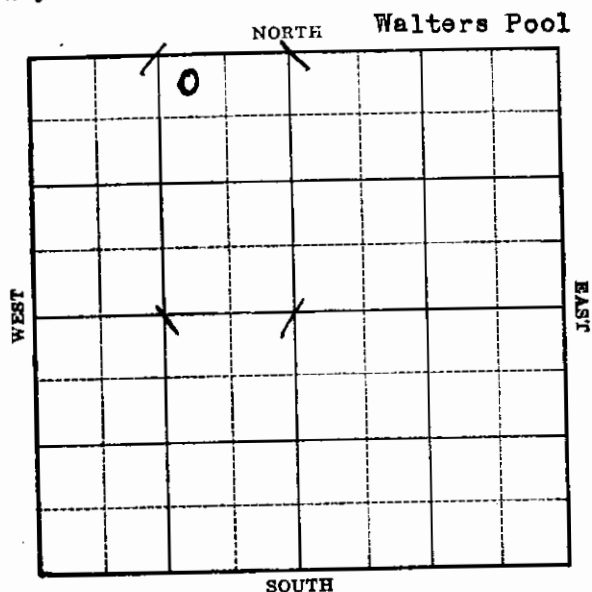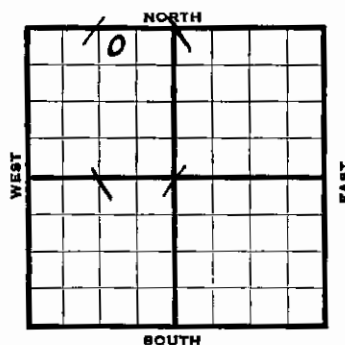

1939	REPORT
1/11	B.R.R.
1/20	Anhy 1415'. 10" - 1431'. Drlg. 2175'.
1/27	Drlg. 3410'.
2/3	Lans. 3425'. Arb. 3691'. T. D. 3693' S. O. 6" - 3691'. RUST.
2/10	T. D. 3697'. 2000' oil 19 hrs. Swab 153 oil in 6 hours. Will treat.
2/15	6" - 3691' Arb. 3691' T. D. 3697' 2000 acid. Pump 582 bbls. 8 hours. Potential 1746 bbls.
	COMPLETED

Ellis KANSAS

Map No. _____ Sec. 13 Twp. 12 R. 18WWell No. 1 A. E. KarlinGulf Oil

Company

Contractor

COMPLETED**SECTION PLAT**

330 NW NE NW
Ft. from N. Line

_____ Ft. from S. Line

990 Ft. from E. Line

_____ Ft. from W. Line

	0		

WALTERS POOL

Location _____

Rig up _____

Drilling and Remarks:

2000 Acid

P-58 7/8

*Pot 1746***RECORD**Cased 6 in., 3691 ft.Sand Arb 3691

Gas _____

Oil _____

Total Depth 3697**PRODUCTION**

1st 24 hrs. Nat. _____

1st 24 hrs. after shot _____

Gas _____ Cu. Ft.

Dry Hole _____

Abandoned _____

Date

FEB 15 1939

19

H. D. Hatfield Scout

Ellis KANSAS

Map No. _____ Sec. 13 Twp. 12 R. 18WWell No. 1 A. E. KarlinGulf Oil

Company

Contractor

330 NW NE NW

330 NW NE NW
Ft. from N. Line

_____ Ft. from S. Line

990 Ft. from E. Line

_____ Ft. from W. Line

WALTERS POOL

SECTION PLAT

	0		

Location _____

Rig up _____

Drilling and Remarks:

BRR**RECORD**

Cased _____ in., _____ ft.

Sand _____

Gas _____

Oil _____

Total Depth _____

PRODUCTION

1st 24 hrs. Nat. _____

1st 24 hrs. after shot _____

Gas _____ Cu. Ft.

Dry Hole _____

Abandoned _____

Date

JAN 11 1938

19

H. D. Hatfield Scout