


SECTION 13 TOWNSHIP 12 RANGE 18W

WELL NO. #2 Linkel "B"

COMPANY Trans-Era

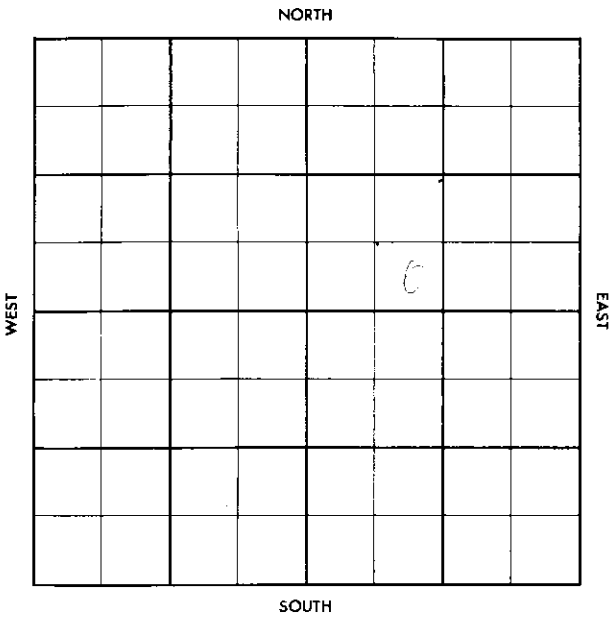

SEC. 13 TWP. 12 R. 18W

WELL NO. #2 Dinkel "B" FARM

COMPANY Trans-Era

CONTRACTOR Co. Tools

Walter


_____ Ft. from N. Line

_____ Ft. from S. Line

_____ Ft. from E. Line

_____ Ft. from W. Line

SE SW NE

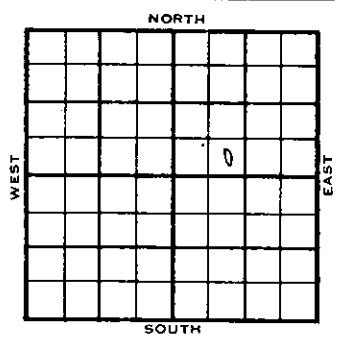

1956 ELEVATION 2176 FB REPORT

3-28 Comm. 3-21-56
8" @ 223/135
Drlg. 2445

4-5 DST 3440-3522 op 1 hr. rec. 65' muddy
sw, 960#
DST 3576-95 op 1 hr. rec. 20' sli.oil
spkd. mud, 0/30"
D & A
F. 333
L. 3428
C. 3674
TD 3750

ABANDONED

DX-78

County **Ellis** Elev. _____
 Sec. **13** Twp. **12** Rge. **18W**
 Company **Trans-Era**
 FarmName **Dinkel "B"** No. **2**

TOPS	DEPTH	LOG	DATUM	Loc. in Sec.
Anh.				SE SW NE
Ip.				
H.				
Tr.				
Dg.				
Bl.				
L.				Geol. _____
K.C.				Contr. _____
B.K.C.				Co. tools
Ce.				Pool _____
C.				Walter
M.				FIRST REPORT
K.				
Me.				MAR 28 '56
V.				
S.				
S.				
A.				
R.				
PC.				
G.				
TD.				

Date Comm. **3-21-56**
8" @ 223/135 drlg. 2/1/5

County **Ellis** Elev. **2176 RB**
 Sec. **13** Twp. **12** Rge. **18W**
 Company **Trans-Era**
 FarmName **Dinkel "B"** No. **2**

TOPS	DEPTH	LOG	DATUM	Loc. in Sec.
Anh.				SE SW NE
Ip.				
H.	3383			
Tr.				
Dg.				
Bl.				
L.	3428		1253	Geol. _____
K.C.				Contr. _____
B.K.C.				Co. tools
Ce.				Pool _____
C.	3674		1499	Walter
M.				ABANDONED
K.				
Me.				APR 4 '56
V.				
S.				
S.				
A.				
R.				
PC.				
G.				
TD.	3750			

Date Comm. **3-21-56**
8" @ 223/135 DST 3440-3522 open 1 hr.
rec. 65' muddr sw 960# DST 3576-95
open 1 hr. rec. 20' sli. oil spkd. mud
0/30"
D & A