

Section 13 Township 12 Range 18 W

Sec. 13 Twp. 12 R. 18W

Well No. #3 Dinkel

Well No. #3 Dinkel Farm

Company Skelly Oil

Skelly Oil Company

Contractor

990' Ft. from N. Line


_____ Ft. from S. Line

_____ Ft. from E. Line

990' Ft. from W. Line


SE NW NE

NORTH

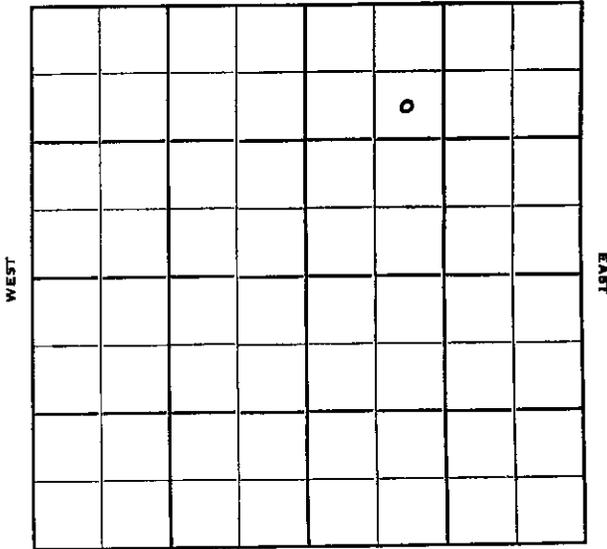

SOUTH

NORTH

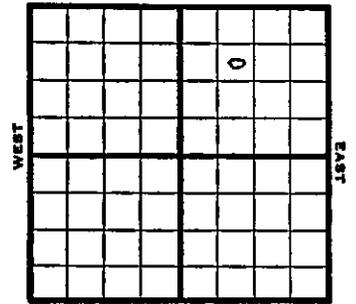

SOUTH

1951 Elev. 2164' REPORT

1/31
3/14

RUR
 Spud 2-1-51
 Oil Well TD 3683'
 8" @ 1413'
 Anhy 1403' Heeb. 3393
 Lans. 3434' Simp 3662
 Arb. 3676
 5" @ 3677 TD 3683
 FU 700' fluid 1 1/2 hr
 P/28 bo 60 bw 17 hr. SP 3680
 5 gwph DD 3681 5 gwph tr. oil
 200 A S/10 bo 5 bw 3 hr
 P 57 bo 52 bw 8 hr
 Comp. 103 bopd 106 bw
 COMPLETED

