

Ellis


KANSAS

SECTION 13 TOWNSHIP 12S RANGE 18W

WELL NO. #3 Dinkel "B"

COMPANY E.K. Edmiston

Top Pool
Co Face

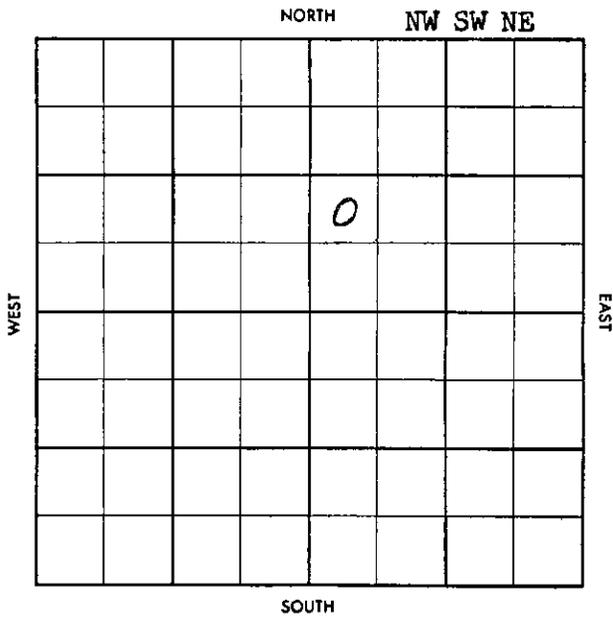

S-513-B

County	Ellis	Elev	2192.05 2195.18
Sec.	13	Twp.	12S
Company	E. K. Edmiston	Rge	18W
Farm Name	Dinkel "B"	No.	3

TOPS	DEPTH	LOG	DATUM
Anh.	1418		
Tr.			
H.	3394		
Dg.			
B.L.			
L.	3439		
K.C.			
B.K.C.			
Ce.			
C.	Chert 3696		
M.			
K.			
Mz.			
Mq.			
V.			
S.	sh 3697		
S.			
A.	3726		
Pf.			
G.			
T.D.	3745		

Loc. in Sec. NW SW NE

Geol. _____

Contr. _____

Pool _____

Walters _____

Sierra #7

WAY 14 '58

ABANDONED

Date Comm. 5-1-58

MIRT MAY 7 '58 8" 205/150 3022

MAY 14 '58 DST 3460-3550 1hr 42'M

BHP 580/20" DST 3727-30 1/2 hr

10'M BHP 860/15" DST 3730-45

1hr 90' 50 & 90' BHP 730

no log

D-68

~~WATER~~

~~WATER~~

-513-B

County Ellis Elev. _____

Sec. 13 Twp. 12 Rge. 18W

Company E. K. Edmiston

Form Name Dinkel "B" No. 3

TOPS	DEPTH	LOG	DATUM	Loc. in Sec.
Anh.				NW SW NE
Tr.				
Dg.				
B.L.				
L.				Geol. _____
K.C.				Contr. _____
B.K.C.				<u>Sierra #7</u>
Ce.				Pool _____
C.				<u>Walters</u>
M.				
M.				
K.				
Mz.				
Mq.				
V.				
S.				
S.				
A.				
R.				
Pf.				
G.				
T.D.				

Date Comm. _____

AIRT

Co

Sec

T

R