


Section 13 Township 12 Range 18 WWell No. # 1 KarlinCompany Glenn Nye Drlg.
Brunson Drlg.

NORTH

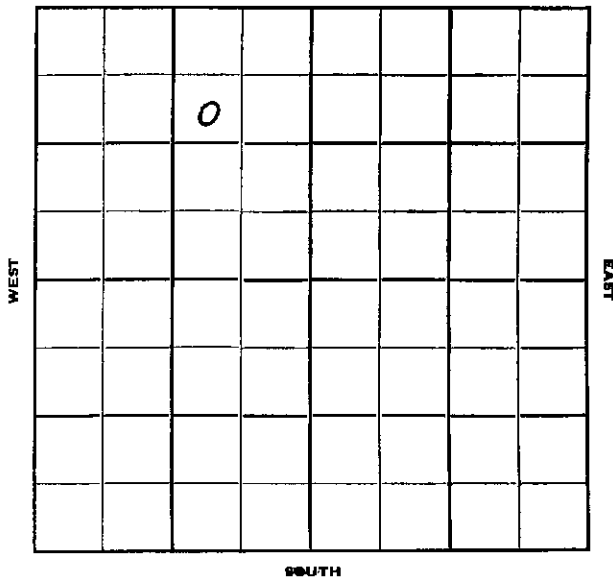

SOUTH

Sec. 13 Twp. 12 R. 18WWell No. #1 Karlin FarmCompany Glenn Nye Drlg.
Brunson Drlg.Contractor Brunson

Walters Pool

990 Ft. from N. Line


Ft. from S. Line

990 Ft. from E. Line

Ft. from W. Line

SW NE NW

NORTH

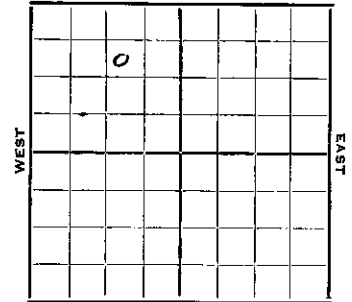

SOUTH

1952 Elev. 2183' REPORT

7/30 Spud 7-28-52
8" @ 200'

8/6 Heeb. 3380 Lans. 3424
Drlg. 3529'

8/13 Arb. 3687
DST 3720-31, 1 hr. 30' HOOM
126' OCM & SW RTD 3760'
5" @ 3760'

8/20 15/3710-15

8/27 NR

9/3 "


9/10 "

9/17 "


9/24 Spud 7-28-52
Oil Well TD 3760'
8" @ 200'
Heeb. 3380 Lans. 3424
Arb. 3687
DST 3720-31 open 1 hr. rec. 30' hoom
126' ocm & sw TD 3760
5" @ 3760' 15/ 3710-15
Comp. 25 BOPD 250 Bw

COMPLETED

OVER

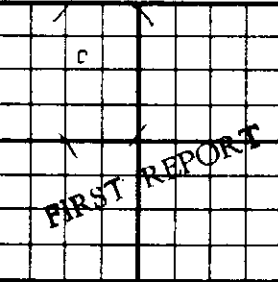County	Ellis	State	Kansas
Sec.	13 (Blk. Twp.)	12 (Sur. Rge.)	18W Map No.
Operator	Brunson Drlg.		
Well No.	1	Farm	Karlin
Elev.	Location SW NE NW		
			
990 Ft. From N Line NW			
990 Ft. From E Line Quarter			
1st. Report JUL 30 1952			
Completion			
Remarks			
Brunson Drlg. - Contr.			
Spudding Date 7-28-52			
Drlg. Data Walters Pool			
8" @ 200			

J. G. McGEHEE

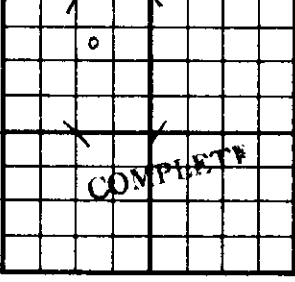County	Ellis	State	Kansas
Sec.	13 (Blk. Twp.)	12 (Sur. Rge.)	18W Map No.
Operator	Brunson Drlg.		
Well No.	1	Farm	Karlin
Elev.	2183	Location SW NE NW	
			
990 Ft. From N Line NW			
990 Ft. From E Line Quarter			
1st. Report			
Completion SEP 24 1952			
Remarks Walters Pool			
Brunson Drlg. - Contr.			
Spudding Date 7-28-52			
Drlg. Data Oil well TD 3760			
8" @ 200 Heeb. 3380 Lans. 3424			
Arb. 3687 DST 3720-31 open 1 hr.			
Rec. 30' hoem 126' ocm & sw TD 3760			
5" @ 3760 15/ 3710-15			
Comp. 25 bopd 250 bw			

J. G. McGEHEE

O.W.W.O.

County	Ellis	State	Kansas																		
Sec.	13 (Blk. Twp.)	12 (Sur. Rge.)	18W Map No.																		
Operator	Glenn Nye Drlg.																				
Well No.	1	Farm	Karlin																		
Elev.	2183	Location	SW NE NW																		
<table border="1"> <tr> <td>990 Ft. From</td> <td>N Line</td> <td>NW</td> </tr> <tr> <td>990 Ft. From</td> <td>E Line</td> <td>Quarter</td> </tr> <tr> <td>1st. Report</td> <td colspan="2">MAY 8 1953</td> </tr> <tr> <td>Completion</td> <td colspan="2"></td> </tr> <tr> <td>Remarks</td> <td colspan="2">O.W.W.O.</td> </tr> <tr> <td>Spudding Date</td> <td colspan="2">O.W.W.O.</td> </tr>

FIRST REPORT

Drig. Data Walter Pool

KC 3424 Arb. 3687 OTD 3760 5" @ 3760

PB 3486 30/ 3470-80 wtr. PB 3486

48/ 3447-62 1000 A 3 bfph 4 hr.

J. G. McGEHEE

O.W.W.O.

County	Ellis	State	Kansas																		
Sec.	13 (Blk. Twp.)	12 (Sur. Rge.)	18W Map No.																		
Operator	Glenn Nye Drlg.																				
Well No.	1	Farm	Karlin																		
Elev.	2183	Location	SW NE NW																		
<table border="1"> <tr> <td>990 Ft. From</td> <td>N Line</td> <td>NW</td> </tr> <tr> <td>990 Ft. From</td> <td>E Line</td> <td>Quarter</td> </tr> <tr> <td>1st. Report</td> <td colspan="2">MAY 20 1953</td> </tr> <tr> <td>Completion</td> <td colspan="2"></td> </tr> <tr> <td>Remarks</td> <td colspan="2">O.W.W.O.</td> </tr> <tr> <td>Spudding Date</td> <td colspan="2">O.W.W.O.</td> </tr>

ABANDONED

Drig. Data D & A TD 3760

KC 3424 Arb. 3687 OTD 3760 5" @ 3760

PB 3486 30/ 3470-80 wtr. PB 3486

48/ 3447-62 1000A 3 bfph 4 hr.

D & A

J. G. McGEHEE