

Sec. 13 Twp. 12 R. 18-W

Section 13 Township 12 Range 18-W

Well No. #2 Karlin Farm


Well No. 2 Karlin

British American Company

Company British American

Walters Pool

NORTH

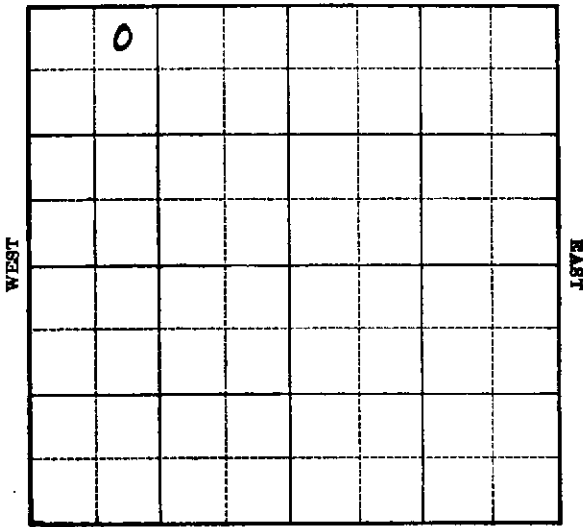

SOUTH

(Walters)


330 Ft. from N. Line

Ft. from S. Line

Ft. from E. Line

990 Ft. from W. Line

Elev. 2182

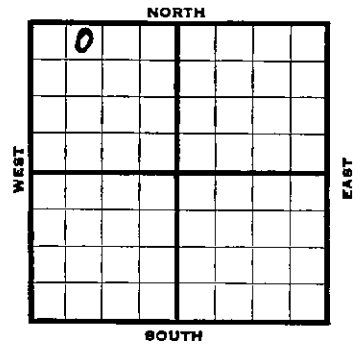

1939	REPORT
3/8	R.U.R.
3/17	10" - 1426' WOC.
3/24	T. D. 2480' Fsg.
3/31	Topeka 3133' Drilg. 3370'
4/7	Cong. 3640' Simp. 3675'
	Arb. 3696' T.D. 3698'
	7" - 3697' RUST.
4/14	T. D. 3699' 1600' oil 30 hrs.
4/21	2000 acid.
	Depthograph potential 3800 ?
4/26	7" - 3697'
	Arb. 3698'
	T. D. 3699'
	2000 acid.
	(Depthograph Potential 3800 bbls.
	Pump 649 bbls. 8 hours.
	Potential 1947 bbls.
	COMPLETED

Ellis

KANSAS

Map No. 71 Sec. 13 Twp. 12 R. 18WWell No. 2 KarlinBritish American Company

Contractor

FIRST REPORT

NE NW NW

330 Ft. from N. Line

Ft. from S. Line

Ft. from E. Line

990 Ft. from W. LineWalters
KARLIN POOL

SECTION PLAT

0			

Location _____

Rig up _____

Drilling and Remarks:

RUR

RECORD

Cased _____ in., _____ ft.

Sand _____

Gas _____

Oil _____

Total Depth _____

PRODUCTION

1st 24 hrs. Nat. _____

1st 24 hrs. after shot _____

Gas _____ Cu. Ft.

Dry Hole _____

Abandoned _____

Date

MAR 8 - 1939

19

H. D. Hatfield

Scout

Ellis

Map No. 71 Sec. 13 Twp. 12 R. 18WWell No. 2 KarlinBritish American Company

Contractor

COMPLETED

NE NW NW

330 Ft. from N. Line

Ft. from S. Line

Ft. from E. Line

990 Ft. from W. Line

WALTERS POOL

SECTION PLAT

0			

Location _____

Rig up _____

Drilling and Remarks:

2000 Acid(Depthograph Pot)
3800 bblsP- 649/8Pot 1947

Date

APR 26 1939 19

H. D. Hatfield Scout

RECORD

Cased 7 in., 3697 ft.Sand Arb 3696

Gas _____

Oil _____

Total Depth 3699

PRODUCTION

1st 24 hrs. Nat. _____

1st 24 hrs. after shot _____

Gas _____ Cu. Ft.

Dry Hole _____

Abandoned _____