

KANSAS

E1118

FORM 51 25M 3-49 PETROL

Ellis

KANSAS

Sec. 13 Twp. 12 R. 18W

Section 13 Township 12 Range 18-W

Well No. #1 Schmidt

Company BradenDrlg & NCRA
Burnett Pool

NORTH

Well No. #1 Schmidt Farm

Braden Drlg. & NCRA Company

Contractor

Burnett Pool

330' Ft. from N. Line


Ft. from S. Line

330' Ft. from E. Line

Ft. from W. Line

NE NE SW

NORTH

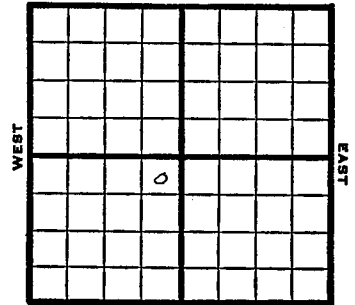

SOUTH

1950

Elev 2170' REPORT

3/8

Spud 3-4-50
8" @ 165'

WCC

3/22

8" @ 165'
Heebner 3394'
Toronto 3414'
Lans 3441'
Cong 3701'
TD 3800'
D&A
Aband.**ABANDONED**

Kansas

Burnett Pool

Map No. _____ Sec. 13 Twp. 12 R. 18W

Well No. 1 Schmidt

Braden Drlg. & NCRA

Company

Contractor

NE NE SW

E1. 2170

SECTION PLAT

330 Ft. from N. Line

Ft. from S. Line

330 Ft. from E. Line

Ft. from W. Line

Ellis County



Location

RECORD

Cased _____ in., _____ ft.

Sand _____

Gas _____

Oil _____

Total Depth _____

PRODUCTION

1st 24 hrs. Nat. _____

1st 24 hrs. after shot _____

Gas _____ Cu. Ft.

Dry Hole _____

Abandoned _____

Rig up

Drilling and Remarks:

8" @ 165

Helmer 3394

Jerome 3414

Lans. 3441

Cong. 3701

T.D. 3800

D & A

Date

MAR 22 1950 19

J. E. TYRA

Scout

Kansas

Burnett Pool

Map No. _____ Sec. 13 Twp. 12 R. 18W

Well No. 1 Schmidt

Braden Drlg. & NCRA

Company

Contractor

NE NE SW

SECTION PLAT

330 Ft. from N. Line

Ft. from S. Line

330 Ft. from E. Line

Ft. from W. Line

Ellis County



Location

RECORD

Cased _____ in., _____ ft.

Sand _____

Gas _____

Oil _____

Total Depth _____

PRODUCTION

1st 24 hrs. Nat. _____

1st 24 hrs. after shot _____

Gas _____ Cu. Ft.

Dry Hole _____

Abandoned _____

Rig up

Drilling and Remarks:

Spud 3-4-50

8" @ 165

WDC

Date

MAR 8 1950 19

J. E. TYRA

Scout