


Ellis KANSAS

Section 18 Township 12 Range 17 W

Well No. # 1 Bicker

Company Birmingham-Bartlett

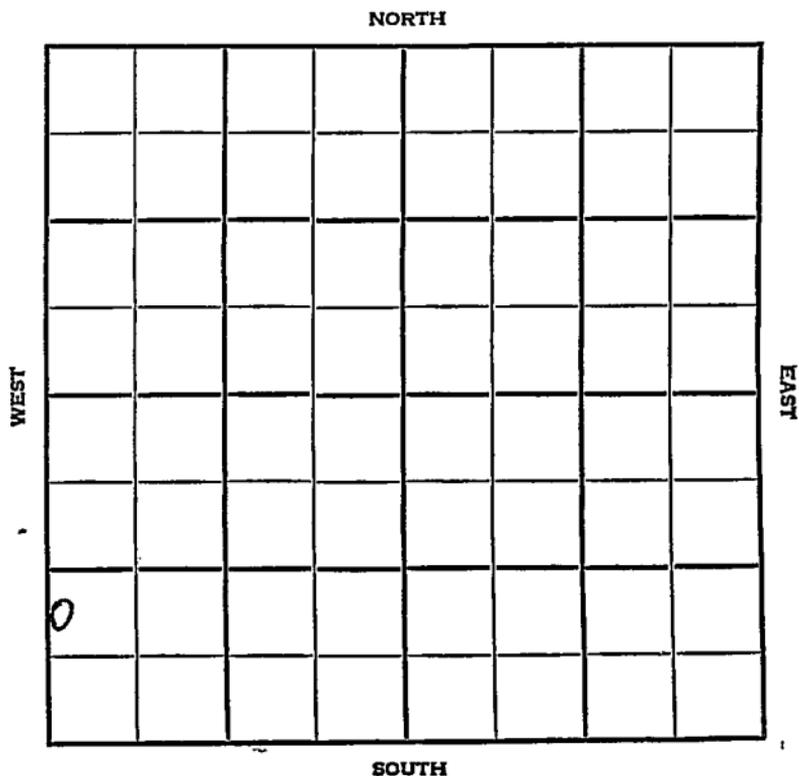

SEC.	TWP.	R.
18	12	17W

WELL NO. #1 Bicker FARM

COMPANY Brimingham-Bartlett

CONTRACTOR Co. Tools.


Pleasant Ridge Pool NORTH

\_\_\_\_\_ Ft. from N. Line

800 \_\_\_\_\_ Ft. from S. Line

\_\_\_\_\_ Ft. from E. Line

180 \_\_\_\_\_ Ft. from W. Line

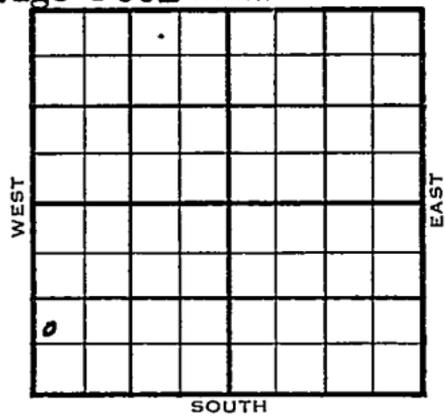

NW SW SW

1955	ELEVATION	REPORT
	2137'	

3/16	Spud3-8-55 Heeb 3349' Dr1g. 3378'
------	---

