

Section 18 Township 12 Range 17W

Well No. #2 Schmeidler

Company Harms & Knight

NORTH

WEST

EAST

Q

SOUTH


Sec. 18 Twp. 12 R. 17 WWell No. # 2 Schmeidler FarmHarms & Knight CompanyHarms & Knight Contractor

Ft. from N. Line

990 Ft. from S. Line330 Ft. from E. Line

Ft. from W. Line

NE SE SE

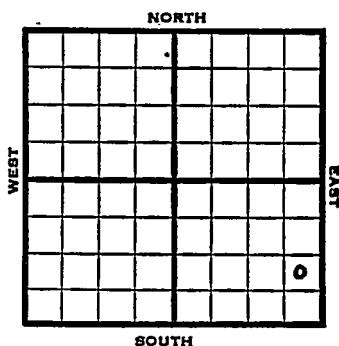

1953

Elev. 2141' REPORT

2/25	Cellar & Pits
3/12	"
3/19	8" @ 145 Drlg. 2107'
3/26	Anhy 1355, Heeb 3346, Tor 3369 Lans 3389 Drlg. 3403'
4/2	DST 3572-3605, -1 hr, 210' HO & GCM 410# Cong. 3644 RTD 3715 5" @ 3713
4/9	NR
4/16	Testing
4/23	"
4/30	"
5/7	"
5/21	"
5/28	N.R.
6/3	"
6/24	NR

OVER

1953

7/1

Spud 3-13-53 Oil well TD 3715

8" @ 145 Anhy 1355 Heeb 3346

Tor. 3369 Lans 3389

DST 3572-3605 open 1 hr rec 210'

HO & GCM 410# Cong. 3644

TD 3715 5" @ 3713 Perf/3641-75

20/3675-79 28/3644-70 20/3590-3600

1000 A S/3 BO 5 BWPH 1500 A


S/40 BO 6 hr. P/30 BO 26 BW 24 hrs.

Comp. 19 BOPD 4 BW

COMPLETED

J. G. McGEHEE

County Ellis State Kansas
 Sec. 18 (Blk. 12 (Sur. 17W Map No. 12 (Twp. Rge.)
 Operator Harms & Knight
 Well No. 2 Farm Schmeidler
 Elev. 2141 Location NE SE SE

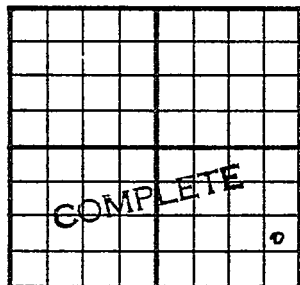

990 Ft. From S Line SE
330 Ft. From E Line Quarter

Ist. Report

Completion JUL 1 1953

Remarks

Harms & Knight - Contr.

Spudding Date 3-13-53

Drilg. Data Oil well TD 3715

8" @ 145 Anhy 1355 Heeb. 3346

Tor. 3369 Lans. 3389 DST 3572-3605

open 1 hr. Rec. 210' ho & gcm 410#

Cong. 3644 TD 3715 5" @ 3713

Perf/ 3641-75 20/ 3675-79 28/ 3644-70

20/ 3590-3600 1000 A S/ 3 bo 5 bwph

1500 A S/ 40 bo 6 hr. P/ 30 bo

26 bw 24 hr. Comp. 19 bopd 4 bw

J. G. McGEHEE