


Section 18 Township 12 Range 17W

Well No. #1 Schmeidler "D"

Company Trans-Era

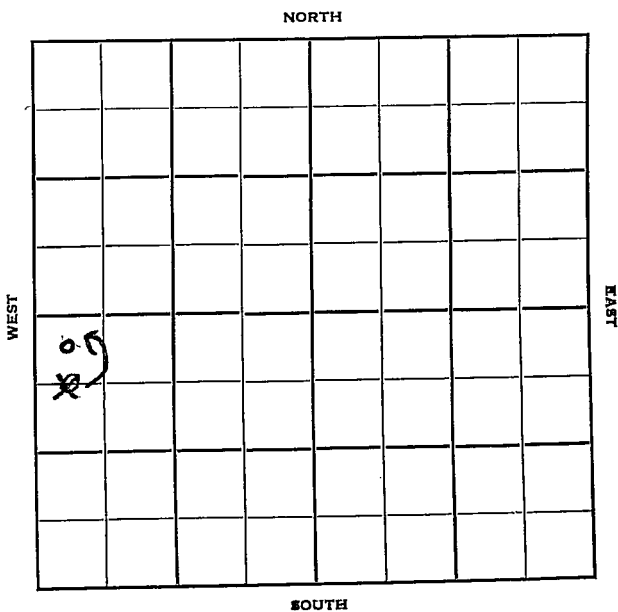

Ellis

KANSAS

Sec. 18 Twp. 12 R. 17 W

Well No. # 1 Schneidler "D" Farm

Trans-Era Company

Trans-Era Contractor

330 Walters Pool


~~660~~ Ft. from N. Line

Ft. from S. Line

Ft. from E. Line

330 Ft. from W. Line

NW NW SW
C L NW SW

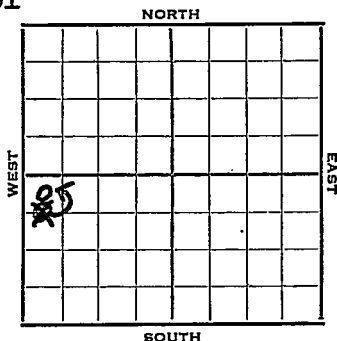

1952 Elev. 2145' REPORT

10/15 Location

10/22 "

10/29 "

11/5 "

11/12 "

11/20 8" @ 204 Anhy 1370'
Drlg. 2235'

11/27 Heeb 3362, KC 3408
DST 3489-3510, 1 hr., 20' OCM,
Drlg. 3630'

12/3 Spud 11-11-52
D&A

TD 3768'

8" @ 204

Anhy 1370, Heeb. 3362, KC 3408,
DST 3489-3510, opn 1 hr., rec.
20' ocm, 750#

Cong 3657, Arb. 3752

TD 3768

D&A

ABANDONED

County Ellis State KansasSec. 18 (Blk.
Twp.) 12 (Sur.
Rge.) 17W Map No.Operator Trans-EraWell No. 1 Farm Schmeidler "D"Elev. Location C W L NW SW

FIRST REPORT

660 Ft. From N Line SW330 Ft. From W Line Quarter1st. Report OCT 15 1952

Completion

Remarks

Trans-Era - Contr.

Spudding Date

Drig. Data Walters PoolLocation

Kansas

Map No. _____ Sec. 18 Twp. 12 R. 17W

Well No. 1 Schmeidler "D"

Trans-Era _____ Company

CORRECTION Contractor

NW NW SW


SECTION PLAT

330 Ft. from N. Line

_____ Ft. from S. Line

_____ Ft. from E. Line

330 Ft. from W. Line

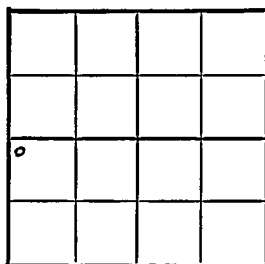

Ellis County

Location _____

Rig up _____

Drilling and Remarks:

Reported

C W L NW SW

4-5

RECORD

Cased _____ in., _____ ft.

Sand _____

Gas _____

Oil _____

Total Depth _____

PRODUCTION

1st 24 hrs. Nat. _____

1st 24 hrs. after shot _____

Gas _____ Cu. Ft.

Dry Hole _____

Abandoned _____

Date


NOV 12 1952

19

J. G. McGEHEE

Scout

County Ellis State Kansas
 Sec. 18 (Blk. 12 (Sur. 17W Map No. 17W)
 Operator Trans-Era
 Well No. 1 Farm Schmeidler "D"
 Elev. 2145 Location NW NW SW

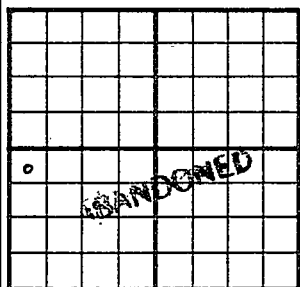

330 Ft. From N Line SW
330 Ft. From W Line Quarter
 1st. Report
 Completion DEC 3 1952
 Remarks Walters Pool
Trans-Era - Contr.
 Spudding Date 11-11-52

Drlg. Data D & A TD 3768
8" @ 204 Anhy 1370 Heeb. 3362
KC 3408 DST 3489-3510 open 1 hr.
Rec. 20' ocm 750# Cong. 3657
Arb. 3752 TD 3768

D & A

J. G. McGEHEE