


Section 18 Township 12 Range 17-W

Well No. #1 Schmeidler

Company Harnes & Knight et al

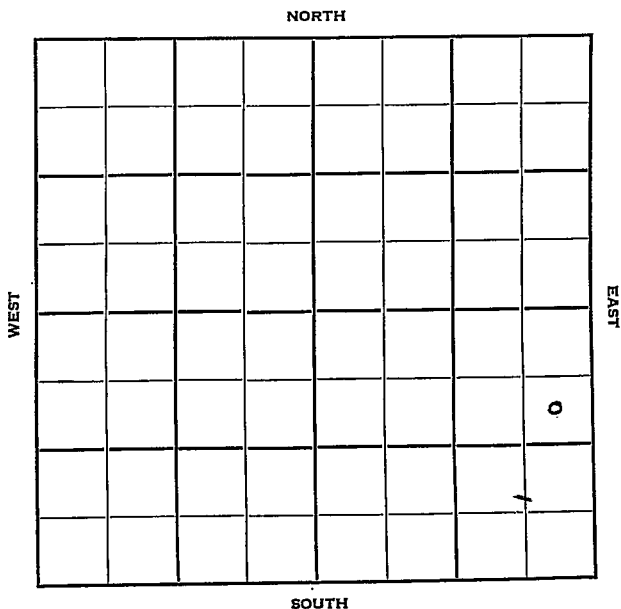

Sec. 18 Twp. 12 R. 17W ✓

Well No. #1 Schmeidler Farm

Harmes & Knight et al Company

Contractor


990' Ft. from N. Line

Ft. from S. Line

330' Ft. from E. Line

Ft. from W. Line

SE NE SE

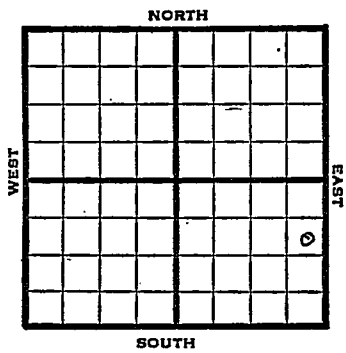

1950

Elev 2146

REPORT

5/24

Rig up

8/2

8" @ 193

Anhy 1353

Heeb 3347

Lans 3392

DST 3396-3412, opn 1/2 hr rec 5' mud

Cong 3648

Arb 3660

TD 3665

5" @ 3662

FU 2100' oil 4 hr

S/84 bo 4 hr

Comp 188 bopd

Completed

COMPLETED

Kansas

Map No. _____ Sec. 18 Twp. 12 R. 17W

Well No. 1 Schmeidler

Harmes & Knight et al _____ Company

Contractor

SE NE SE

SECTION PLAT

990 Ft. from N. Line

_____ Ft. from S. Line

330 Ft. from E. Line

_____ Ft. from W. Line

FIRST REPORT			
			○

Ellis

Location _____

Rig up _____ X

Drilling and Remarks:

RECORD

Cased _____ in., _____ ft.

Sand _____

Gas _____

Oil _____

Total Depth _____

PRODUCTION

1st 24 hrs. Nat. _____

1st 24 hrs. after shot _____

Gas _____ Cu. Ft.

Dry Hole _____

Abandoned _____

Date

MAY 24 1919

J. E. TYRA Scout

