

Map No. KANSAS Sec. 18

Twp. 12

R. 17^w

Well No. 1-2-9

Stadd

Farm

Phillips

Ref

Company

NORTH

WEST

EAST

SOUTH

Location _____

Drilling Remarks _____

Rig Up _____

Drilling Remarks _____

RECORD

Cased _____ in. _____ ft.

Sand _____

Gas _____

Oil _____

Total Depth _____

PRODUCTION

1st 24 hrs. Nat. _____

1st 24 hrs. after shot _____

Gas _____ cu. ft.

Dry Hole _____

Abandoned _____

Map No. KANSAS Sec. 18 Twp. 12 R. 17^W
 Well No. 1- J. J. Stadd Farm
Phillips Co. Company


330 Ft. from N. Line

_____ Ft. from S. Line

1320 Ft. from E. Line

_____ Ft. from W. Line

1930

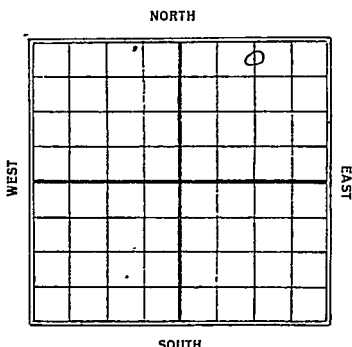

Date

REPORT

6/11	Loc
6/18	—
6/25	Rig
7/2	Rign up
7/9	—
7/16	hrlg 615'
7/23	" 715'
7/30	Skid rig 50' north
8/6	Rign sup.
8/13	—
8/20	Drly 750'
8/27	" 780'
9/3	" 805'
9/10	" 1218'
9/17	" 1560'
9/24	" 2230'
10/1	U/P 10"- 2800'
10/8	Cy out 2800'
10/15	U/R 10"- 2800'
10/22	U/R 8"- 3180'
10/29	U/R 8"- 3457'

11/5- Wrlg. 3461'

11/12 2 1/2" 6"- 3700'

11/19- TD. 3919

dry & abandon

Map No. 71 **KANSAS** Sec. 18 Twp. 12 R. 17W

Well No. 1 J. J. Starnick

Phillips P. Co. Company

Contractor


SECTION PLAT

830 Ft. from N. Line

..... Ft. from S. Line

1320 Ft. from E. Line

..... Ft. from W. Line

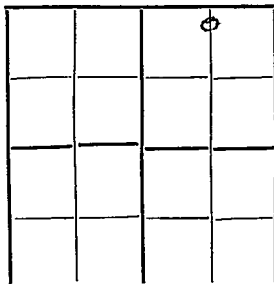

FIRST REPORTS

Location ✓

Rig up

Drilling and Remarks:

RECORD

Cased in., ft.

Sand

Gas

Oil

Total Depth

PRODUCTION

1st 24 hrs. Nat.

1st 24 hrs. after shot

Gas Cu. Ft.

Dry Hole

Abandoned

Date

JUN 11 1930

192

S. J. LEWIS

Scout

Map No. KANSAS Sec. 18 Twp. 12 R. 12 W.

Well No. 71 1st Stoddard

Phillips P & S. Company

Contractor

SECTION PLAT

330 Ft. from N. Line

..... Ft. from S. Line

1320 Ft. from E. Line

..... Ft. from W. Line

			6

ABANDONED

Location.....

Rig up.....

Drilling and Remarks:

RECORD

Cased..... in., ft.

Sand.....

Gas.....

Oil.....

Total Depth 3919

PRODUCTION

1st 24 hrs. Nat.....

1st 24 hrs. after shot.....

Gas..... Cu. Ft.

Dry Hole.....

Abandoned.....

Date

NOV 19 1930 S. J. LEWIS Scout