


Section 2 Township 12 Range 19 W
 Well No. # 1 Leimiller
 Company Brunson Drlg.

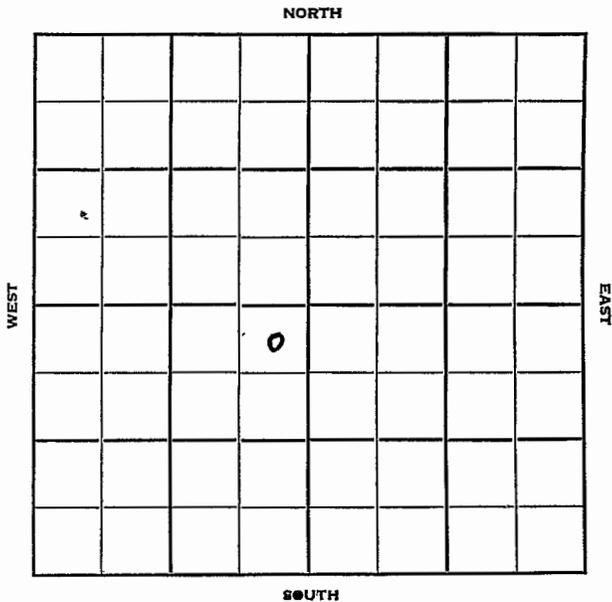


Sec. 2 Twp. 12 R. 19W
 Well No. #1 Leimiller Farm
Brunson Drlg. Company

330 Wildcat
 Ft. from N. Line

_____ Ft. from S. Line

330 Ft. from E. Line

_____ Ft. from W. Line

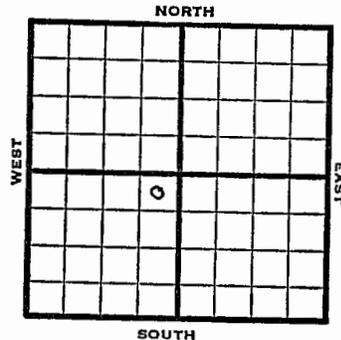

NE NE SW
 Stanolind FO

1952 Elev. 2149' REPORT

8/13 Spud 8-10-52
 8" @ 210'
 Drlg. 2100'


8/20 Anhy 1475' Heeb 3380' Tor. 3397'
 Lans. 3419'
 DST 3452-3510, 3/4 hr, 610' wtr. 1100#
 Arb. 3699'
 DST 3699-3703, 1/2 hr, 5' M 0#
 Drlg. 3703'

8/27 Spud 8-10-52
 D&A TD 3750' 8" @ 210'
 Anhy 1475 Heeb. 3380
 Tor. 3397 Lans: 3419
 DST 3452-3510 open 3/4 hr.
 rec. 610' wtr. 1100# Arb. 3699
 DST 3699-3703 open 1/2 hr. rec. 5' mud
 0#
 DST 3669-3711 open 1/2 hr. rec. 8' mud
 240# TD 3750' D&A

ABANDONED

County Ellis State Kansas
 Sec. 2 (Blk. Twp.) 12 (Sur. Rge.) 19W Map No.
 Operator Brunson Drlg.
 Well No. 1 Farm Leinmiller

Elev. _____ Location NE NE SW

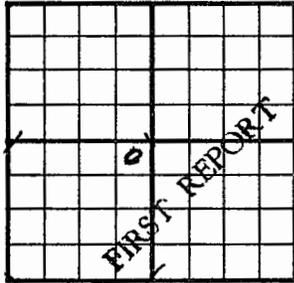


330 Ft. From N Line SW
330 Ft. From E Line Quarter
 Ist. Report AUG 13 1952
 Completion _____
 Remarks Stanolind-FO
 Spudding Date 8-10-52

Drlg. Data Wildcat
8" @ 210 Drlg. 2100

J. G. McGEHEE

County Ellis State Kansas
 Sec. 2 (Blk. Twp.) 12 (Sur. Rge.) 19W Map No.
 Operator Brunson Drlg.
 Well No. 1 Farm Leinmiller

Elev. 2149 Location NE NE SW

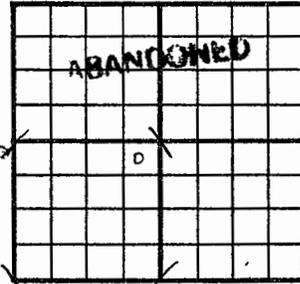

330 Ft. From N Line SW
330 Ft. From E Line Quarter
 Ist. Report _____
 Completion AUG 27 1952
 Remarks Wildcat
 Spudding Date 8-10-52

Drlg. Data D & A TD 3750

8" @ 210 Anhy 1475 Heeb. 3380
Tor. 3397 Lans. 3419 DST 3452-3510
open 3/4 hr. Rec. 610' water 1100#
Arb. 3699 DST 3699-3703 open 1/2 hr.
Rec. 5' mud 0# DST 3699-3711 open 1/2 h.
Rec. 8' mud 240# TD 3750

D & A

J. G. McGEHEE

Scout Cards
Land Small Map
Land Wall Map
Tracings
France Map
Pierce Map
Misc.

AUG 15 1952

Prig. Data

Scout Cards
Land Small Map
Land Wall Map
Tracings
France Map
Pierce Map
Misc.

SEP 5 1952

Prig. Data