



Ellis KANSAS
 SECTION 4 TOWNSHIP 12 RANGE 19W
 WELL NO. #1 Nicholson "D" (WH6-BH22)
 COMPANY Petroleum Inc.

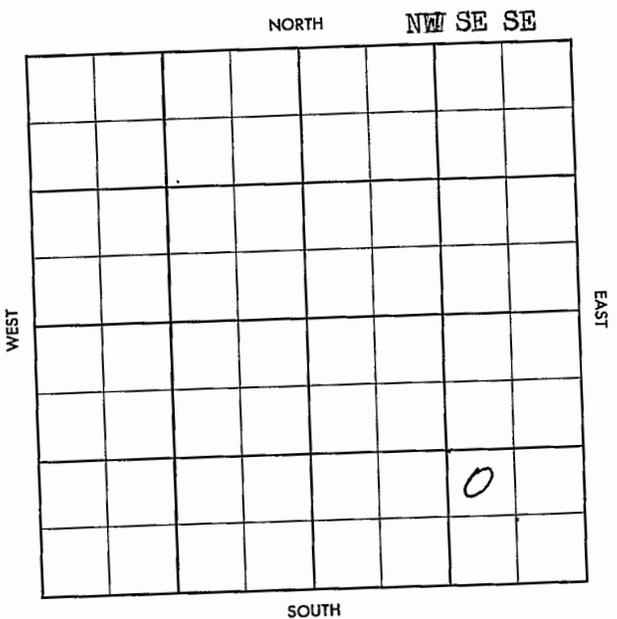

HOT FILE Ellis KANSAS
 SEC. 4 TWP. 12 S R. 19 W.
 WELL NO. #1 Nicholson "D"
 COMPANY Petroleum Inc. (EXPLORATORY-OBOC)
 CONTRACTOR Co. tools.

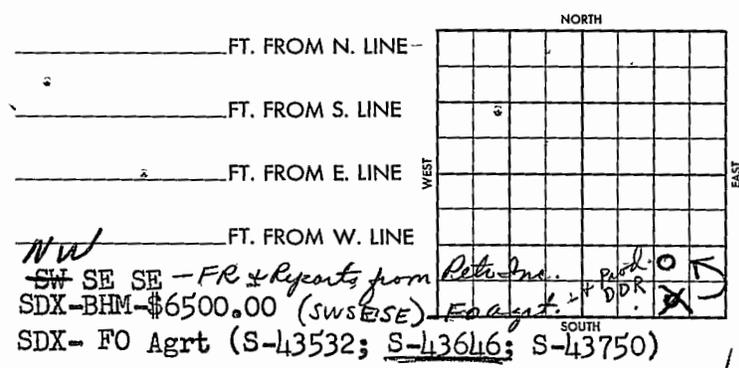

	ELEVATION	REPORT
1957	2180' RB	(WH6-BH22) ✓
6/20	To penetrate 50' into the Arbuckle formation appx 3800' To be commenced by June 15, 1957 To be completed by July 15, 1957 (See copy FO Agrt. 6-10-57)	
7/10	Amendment extending commencement date to 7-15-57 and completion date to 8-15-57	
7/12	Spud 7-10-57 Set 8-5/8" @ 213 w/150 Drlg. 1280' (Card-Petr. Inc)	
7/15	Drlg. 3225'	
7/16	Heebner ³³⁹¹ 3391 , Toronto ³⁴⁰⁸ 3412 , Lansing ³⁴³⁰ 3434 Drlg. 3450 ³⁴⁵⁰ (FR Tkt)	
7/17	Corrected tops (4' up hole): Heebner 3391', Toronto 3408', Lansing 3430' DST 3437-3515' open 1 hr, 158' mud. IFP 100# FFP 200#. BHP 900# 20" Drlg. 3551' (DR#1140) (Card-PetrIn)	
7/18	DST #2, 3553-77', open 1 hr, weak blow 5", 20' mud. IFP 0# FFP 0# BHP 0# 20". Drlg. @ 3670' "	
7/19	Conglomerate Chert 3703' Conglomerate Sand 3725' Circulating @ 3755'. Logging Looking for Arbuckle. "	

OVER

1957

7/22

Arbuckle 3789' RTD 3800'
D & A Complete 7-20-57 (Card-Petr. Inc)

7/23

TD 3800' P & A (DR#142)

7/24

Comm. 7-10-57
8" @ 213/150
Heeb. 3391', Tr. 3408', Lans. 3430'
DST 3437-3515, open 1 hr rec 158'
mud. FP 100-200# BHP 900# 20"
DST 3553-77, open 1 hr rec 20' mud.
BHP 0#. Cherty cg. 3703', Sdy cg 3725'
Arb. 3789'
RTD 3800' D & A (Scout Comp. Tkt)

ABANDONED

8/1 (Advised Contract Section- D & A) ✓

FORM 513 SUNRAY

County Ellis Elev. 2130
Sec. 4 Twp. 12 Rge. 19W
Company Petroleum Inc.
FarmName Nicholson "D" No. 1

	DEPTH	LOG	DATUM	Loc. in Sec.
M	<u>3391</u>	<u>3395</u>		NW SE SE
Tr.	<u>3408</u>	<u>3412</u>		
Dg.				
Bl.				
L.	<u>3430</u>	<u>3434</u>		
K.C.				Geol.
B.K.C.				Contr.
Ce.				Co. tool
C.	<u>cherty</u>	<u>3703</u>		# <u>17</u>
M.	<u>sdg</u>	<u>3725</u>		Pool
K.				
Mz.				
Mo.				
V.				
S.				
A.				
R.				
PE.				
G.				
TD.	<u>3800</u>		<u>WHG-BH-22</u>	

JUL 24 57
ABANDONED

Date Comm. 7-10-57 SDX - FO
8" @ 213/150 drlg. 3450 JUL 24 57 X

Corrected tops Hb 3391 Tr 3408 Lsg
3430 DST 3437-3515 up thru res.
158' Md FP 100-200 BHP 900/20"
DST 3553-77 up thru res. 20' Md
BHP 0 cherty c9 3703 sdg c9 3725
Arb 3789 RTD 3800 D&A

Fig to G430 200 for well

W.P.I. JUL
M.M.

FORM 513 SUNRAY

County Ellis Elev. 2180
Sec. 4 Twp. 12 Rge. 19W
Company Petroleum Inc.
FarmName Nicholson "D" No. 1

	TOPS	DEPTH	LOG	DATUM	Loc. in Sec.
Anh.					NW SE SE
Tr.		<u>3391</u>			
H.		<u>3395</u>			
Tr.		<u>3412</u>	<u>3408</u>		
Dg.					
Bl.					
L.		<u>3434</u>	<u>3430</u>		Geol.
K.C.					Contr.
B.K.C.					Co. tools
Ce.					Pool
C.					
M.					
K.					
Mz.					
Mo.					
V.					
S.					
A.					
R.					
PE.					
G.					
TD.					

FIRST REPORT

JUL 17 57

Date Comm. 7-10-57 SDX - FO
8" @ 213/150 drlg. 3450 (WHG-BH-22)

[Handwritten signature]