

6-12-~~now~~
19

ad

PE

AFFIDAVIT OF COMPLETION FORM

ACO-1 WELL HISTORY

SIDE ONE

Two (2) copies of this form shall be filed with the Kansas Corporation Commission, 200 Colorado Derby Building, Wichita, Kansas 67202, within thirty (30) days after the completion of a well, regardless of how the well was completed.

Attach separate letter of request if the information is to be held confidential. If confidential, only file one copy: Information on Side One will be of public record and Side Two will then be held confidential.

Applications must be made on dual completion, commingling, salt water disposal, injection and temporarily abandoned wells.

Attach one copy only wireline logs (i.e. electrical log, sonic log, gamma ray neutron log, etc.). (Rules 82-2-105 & 82-2-125) KCC# (316) 263-3238.

LICENSE # 6518 EXPIRATION DATE 4-1-85

OPERATOR Wamego Oil, Inc. API NO. 15-051-24,105

ADDRESS P.O. Box 907 COUNTY Ellis

Junction City, Kansas 66441 FIELD Wildcat

** CONTACT PERSON Harold Sadowski PROD. FORMATION Arbuckle

PHONE 913-238-8954

PURCHASER None LEASE Massier

ADDRESS WELL NO. 1 (One)

WELL LOCATION 100'E SW-SW-NE

DRILLING Pioneer Drilling Co., Inc. 2310 Ft. from North Line and

CONTRACTOR 308 West Mill 2210 Ft. from East Line of

ADDRESS Plainville, Kansas 67663 the NE (Qtr.) SEC 6 TWP 12S RGE 19W.

PLUGGING Pioneer Drilling Co., Inc.

CONTRACTOR 308 West Mill

ADDRESS Plainville, Kansas 67663

TOTAL DEPTH 3801 PBTD N/A

SPUD DATE 12-14-84 DATE COMPLETED 12-21-84

ELEV: GR 2146' DF 2149' KB 2151'

DRILLED WITH (CABLE) (ROTARY) (AIR) TOOLS.

DOCKET NO. OF DISPOSAL OR REPRESSURING WELL BEING USED TO DISPOSE OF WATER FROM THIS LEASE N/A


Amount of surface pipe set and cemented 259' DV Tool Used? N/A

THIS AFFIDAVIT APPLIES TO: (Circle ONE) - Oil, Gas, Shut-in Gas Dry Disposal, Injection, Temporarily Abandoned, OWWO. Other

ALL REQUIREMENTS OF THE STATUTES, RULES AND REGULATIONS PROMULGATED TO REGULATE THE OIL AND GAS INDUSTRY HAVE BEEN FULLY COMPLIED WITH.

WELL PLAT

(Office Use Only)

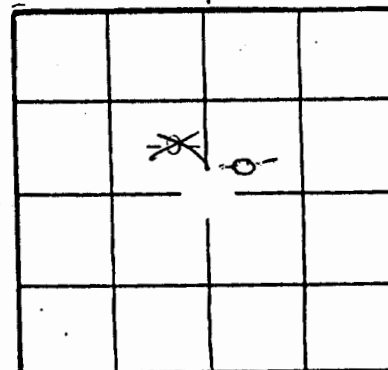

KCC ☒

KGS ☒

SWD/REP ☐

PLG. ☐

A F F I D A V I T

Harold Sadowski, being of lawful age, hereby certifies that:

I am the Affiant, and I am familiar with the contents of the foregoing Affidavit. The statements and allegations contained therein are true and correct.

Harold Sadowski
(Name)

SIDE TWO

 OPERATOR Wamego Oil, Inc. LEASE Massier #1 ACO-1 WELL HISTORY
 SEC. 6 TWP. 12 SRGE. 10W
FILL IN WELL LOG AS REQUIRED:

Show all important zones of porosity and contents thereof; cored intervals, and all drill-stem tests, including depth interval tested, cushion used, time tool open, flowing and shut-in pressures, and recoveries.

SHOW GEOLOGICAL MARKERS, LOGS RUN, OR OTHER DESCRIPTIVE INFORMATION.

FORMATION DESCRIPTION, CONTENTS, ETC.	TOP	BOTTOM	NAME	DEPTH
Anhydrite 1511'	+640			
Anhydrite - Base		+591		
Topeka 3191'	-1040			
Heebner 3148'	-1267			
Toronto 3444'	-1293			
Lansing 3461'	-1310	-1543		
Conglomerate 3755'	-1604			
R. T. D. 3801	-1650			
<u>NO ELECTRIC LOG</u> <u>NO DRILL STEM TESTS</u>				

 Report of all strings set — surface, intermediate, production, etc. **CASING RECORD** (New) or (Used)

Purpose of string	Size hole drilled	Size casing set (in O.D.)	Weight lbs/ft.	Setting depth	Type cement	Sacks	Type and percent additives
Surface Casing	12 1/4"	8-5/8"	20#	259'	60-40 POS	196	3% CC 7% GEL

LINER RECORD**PERFORATION RECORD**

None

Top, ft.	Bottom, ft.	Sacks cement	Shots per ft.	Size & type	Depth interval
TUBING RECORD					
Size	Setting depth	Packer set at			