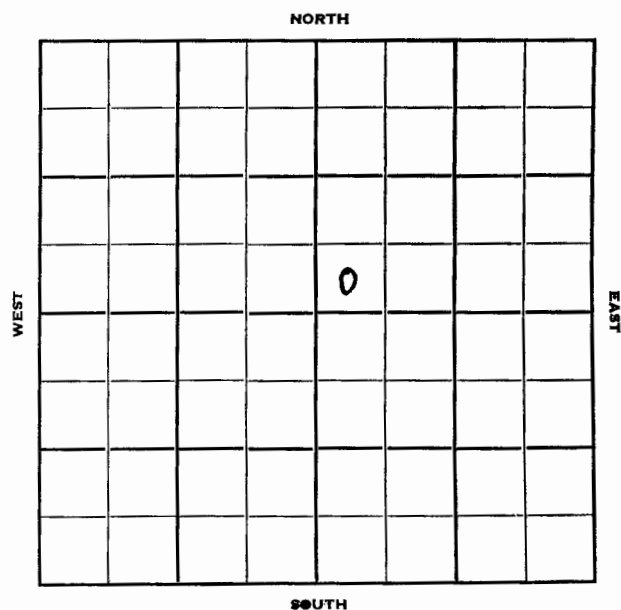


Ellis

KANSAS

Section 8 Township 12 Range 19 WWell No. # 1 SpreenCompany Braden Drlg.

Ellis

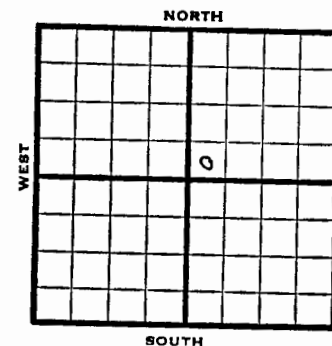
KANSAS

Sec. 8 Twp. 12 R. 19WWell No. #1 SpreenCompany Braden Drlg.Contract Wildcat

Ft. from N. Line

330 Ft. from S. Line

Ft. from E. Line

330 Ft. from W. Line

SW SW NE
Stanolind DHM
Atlantic-support

1952

Elev. 2160

REPORT

8/13 Location

8/20 "

8/27 8" @ 250

9/3 Drlg. 2585'

9/10 Spud 8-23-52

D&A TD 3800

8" @ 250 Heeb. 3412 Tor. 3428

Lans. 3452

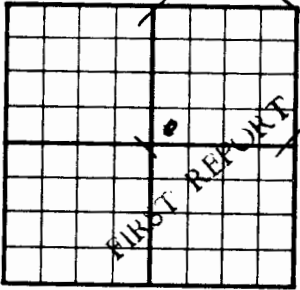
DST 3500-3540 opn 1 hr. Rec. 30'

ho & gcm 60' so & gcm 1120#

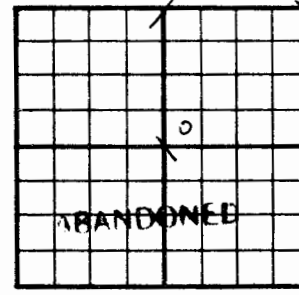
BKC 3658 Cong. 3726 Arb. 3750

TD 3800 D&A

ABANDONED

County **Ellis** State **Kansas**
 Sec. **8** (Blk. **12** (Sur. **19W** Map No.
 Operator **Braden D. lg.**
 Well No. **1** Farm **Spreen**
 Elev. Location **SW SW NE**

330 Ft. From **S** Line **NE**
330 Ft. From **W** Line Quarter
 Ist. Report **AUG 13 1952**
 Completion
 Remarks **Stanolind-DHM**
Atlantic-support
 Spudding Date
 Drlg. Data **Wildcat**
Location

J. G. McGEHEE

County **Ellis** State **Kansas**
 Sec. **8** (Blk. **12** (Sur. **19W** Map No.
 Operator **Braden Drlg.**
 Well No. **1** Farm **Spreen**
 Elev. **2160** Location **SW SW NE**

330 Ft. From **S** Line **NE**
330 Ft. From **W** Line Quarter
 Ist. Report **SEP 10 1952**
 Completion
 Remarks **Wildcat**
 Spudding Date **8-23-52**

Drlg. Data **D & A TD 3800**
8" @ 250 Heeb. 3412 Tor. 3428
Lans. 3452 DST 3500-3540 open 1 hr.
Rec/ 30' ho & gcm 60' so & gcm 1120#
B KC 3658 Cong. 3726 Arb. 3750
TD 3800

D & A

J. G. McGEHEE

Orig. Data

AUG 15 1952

Scout Cards
Land Small Map
Land Wall Map
Tracings
France Map
Pierce Map
Misc.

Orig. Data

Scout Cards
Land Small Map
Land Wall Map
Tracings
France Map
Pierce Map
Misc.

SEP 17 1952