

Section 8 Township 12 Range 19W

Well No. #1 Spleen

Company Stewart Bailey

SEC. <u>8</u>	TWP. <u>12</u>	R. <u>19W</u>
---------------	----------------	---------------

WELL NO. #1 Spleen FARM

COMPANY Stewart Bailey

CONTRACTOR Schaeffer


330 Ft. from N. Line

\_\_\_\_\_ Ft. from S. Line


330 Ft. from E. Line

\_\_\_\_\_ Ft. from W. Line

NE NE NE

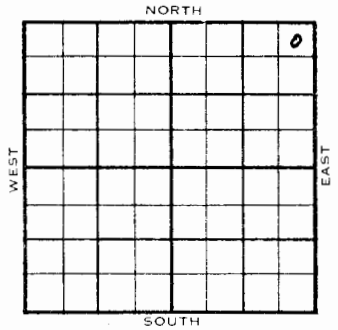

NORTH

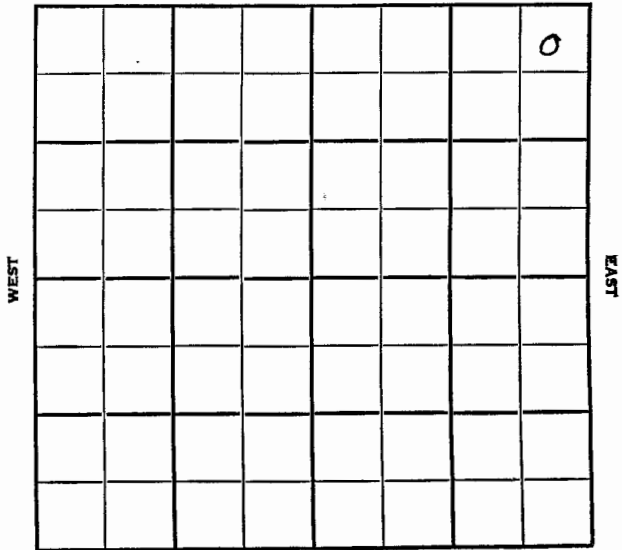

SOUTH

1955

ELEVATION

REPORT

4/6

Location



Orig. Data

