

Section 9 Township 12 Range 19W

Well No. #1 Younger

Company Cities Service

Sec. 9 Twp. 12 R. 19W

Well No. #1 Younger Farm

Cities Service Company



Wildcat

 Ft. from N. Line

330 Ft. from S. Line

330 Ft. from E. Line

 Ft. from W. Line

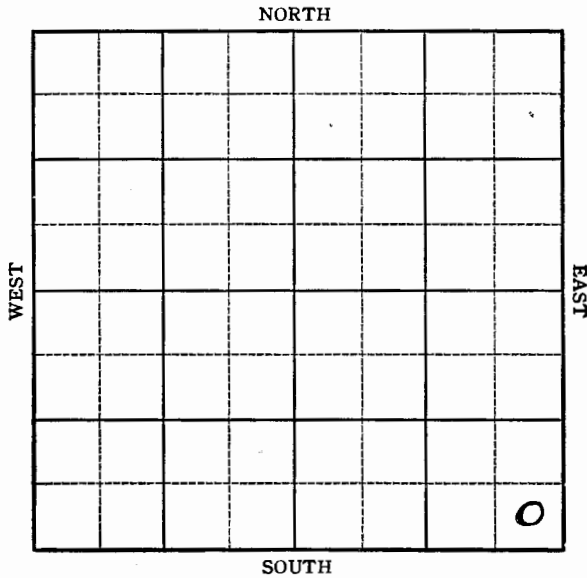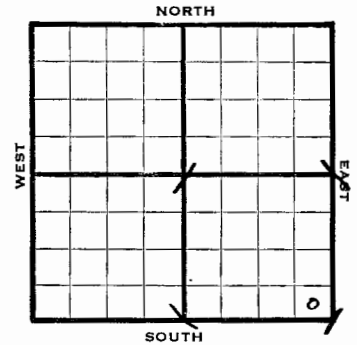

1944	<i>Elev. 2239</i> REPORT
4/19	Location
4/26	"
5/3	"
5/10	"
5/17	Rotary
5/24	8" @ 237 Drlg. 2280
5/31	Drlg. 3432
6/7	Topeka 3280 Lans 3531 Arb. 3907 TD 3938

ABANDONED

KANSAS
 Pool Name Wildcat
 Map No. 70 Sec. 9 Twp. 12 R. 19


Well No. 1 Younger

Cities Service Company

FIRST REPORT Contractor

SE/C

SECTION PLAT

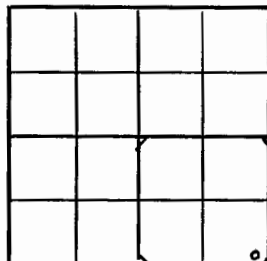

Ft. from N. Line

330

Ft. from S. Line

330

Ft. from E. Line

Ft. from W. Line

Ellis County

Location X

Rig up

Drilling and Remarks:

RECORD

Cased _____ in., _____ ft.

Sand _____

Gas _____

Oil _____

Total Depth _____

PRODUCTION

1st 24 hrs. Nat. _____

1st 24 hrs. after shot _____

Gas _____ Cu. Ft.

Dry Hole _____

Abandoned _____

Date

APR 19 1944 19 S. J. LEWIS Scout

KANSAS
 Pool Name Wildcat
 Map No. 70 Sec. 9 Twp. 12 R. 19W


Well No. 1 Younger

Cities Service Company

ABANDONED Contractor

SE/C

SECTION PLAT

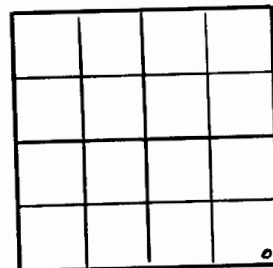

Ft. from N. Line

330

Ft. from S. Line

330

Ft. from E. Line

Ft. from W. Line

Ellis County

Location _____

Rig up

Drilling and Remarks:

Type ka 3280

Line 3531

Ar 3907

RECORD

Cased _____ in., _____ ft.

Sand _____

Gas _____

Oil _____

Total Depth 8938

PRODUCTION

1st 24 hrs. Nat. _____

1st 24 hrs. after shot _____

Gas _____ Cu. Ft.

Dry Hole _____

Abandoned _____

Date

JUN 7 1944 19 S. J. LEWIS Scout

[Handwritten signature]