


KANSAS Ellis

Section 15 Township 12 Range 19W

Well No. 1 Bemis "A"

Company Herndon Drlg

Wildcat
NORTH

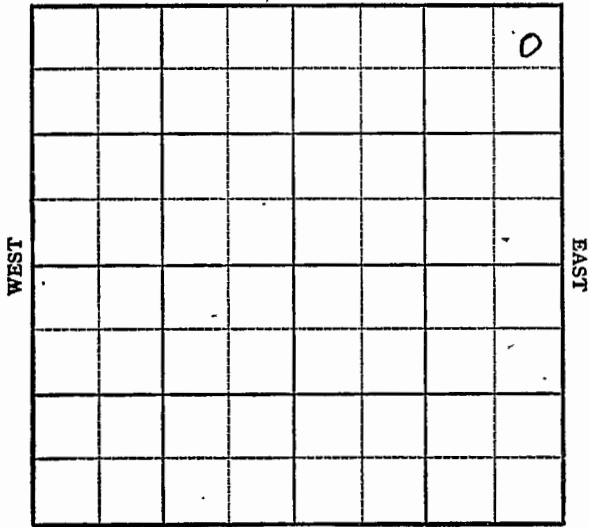

SOUTH

KANSAS Ellis ✓

Sec. 15 Twp. 12 R. 19W

Well No. 1 Bemis "A" Farm _____

Herndon Drlg. Company _____

Wildcat


330 Ft. from N. Line

_____ Ft. from S. Line

330 Ft. from E. Line

_____ Ft. from W. Line

NE/C

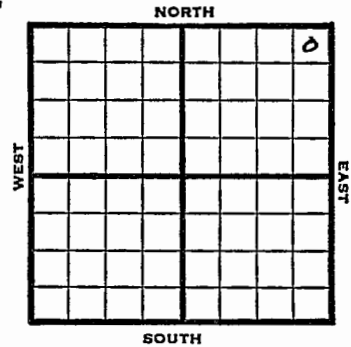

1948

Eli 2225' REPORT

11/17

Location

11/23

8" @ 200'

Drlg 3060'

12/1

TD 4015'

Lansing 3542'

Arb 3968'

Aband.

ABANDONED

Map No. 70 Sec. 15 Twp. 12 R. 19W

Well No. 1 Bemis "A"

Herndon Drlg. Company

ABANDONED Contractor

NE/C

E12225
SECTION PLAT

330 Ft. from N. Line

_____ Ft. from S. Line

330 Ft. from E. Line

_____ Ft. from W. Line

				o

Ellis County

Location _____

Rig up _____

Drilling and Remarks:

Same 3542

Case 48965

RECORD

Cased _____ in., _____ ft.

Sand _____

Gas _____

Oil _____

Total Depth 4015

PRODUCTION

1st 24 hrs. Nat. _____

1st 24 hrs. after shot _____

Gas _____ Cu. Ft.

Dry Hole _____

Abandoned _____

Date

DEC 1 1948 19

S. J. LEWIS Scout

Map No. _____ Sec. 15 Twp. 12 R. 19W

Well No. 1 Bemis "A"

Herndon Drlg. Company

FIRST REPORT Contractor

NE/C

SECTION PLAT

330 Ft. from N. Line

_____ Ft. from S. Line

330 Ft. from E. Line

_____ Ft. from W. Line

				o

Ellis County

Location X

Rig up _____

Drilling and Remarks:

RECORD

Cased _____ in., _____ ft.

Sand _____

Gas _____

Oil _____

Total Depth _____

PRODUCTION

1st 24 hrs. Nat. _____

1st 24 hrs. after shot _____

Gas _____ Cu. Ft.

Dry Hole _____

Abandoned _____

Date

NOV 17 1948 19

S. J. LEWIS Scout

Scout Cards

Land Small Map


Land Wall Map

Tracings

France Map

Pierce Map

Misc.

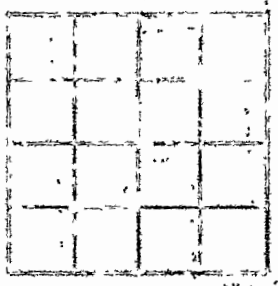













