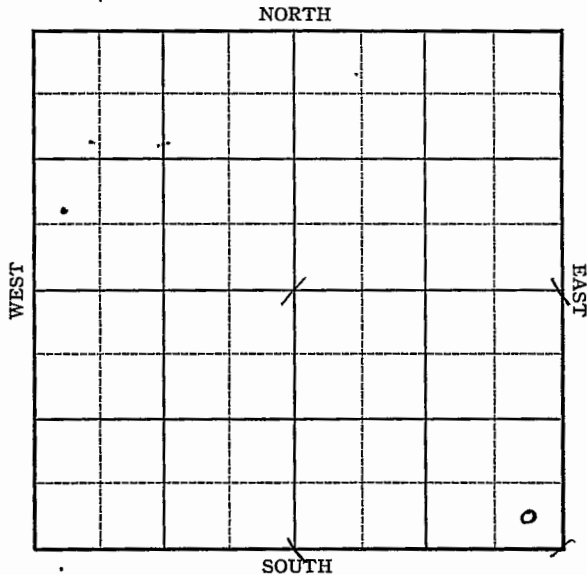


KANSAS

FORM 51 5M 1-42 PETROL

Ellis


Section 16 Township 12 Range 19-WWell No. #1 GalathartCompany CoralenaFORM 252-A
5M 9-42 GASS

KANSAS

Ellis

Sec. 16 Twp. 12 R. 19-WWell No. #1 Galathart FarmCoralena Company

Wildcat

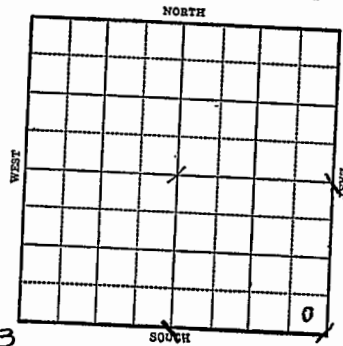 Ft. from N. Line330 Ft. from S. Line330 Ft. from E. Line Ft. from W. LineElev. 2183

1943

R E P O R T

6/23 Rotary

6/30 10" @ 126'
Anhy 1480'
Drlg. 2375'

7/7 Topeka 3235
Lans 3500 SO
T.D. 3560
5" @ 3554 Rust

7/15 36 shots 3504-14
2000' oil 12 hrs.
S.D. for tanks

7/21 Lans 3500
5" @ 3554
T.D. 3560'
36 shots 3504-14
2000 acid
Pump 275 Pot
Gravity 24

COMPLETED

Form 26 200 Bks 5-42 Petrol **Ellis**
KANSAS
Map No. 70 Sec. 16 Twp. 12 R. 19W
Well No. 1 Galathart
Coralena Company
COMPLETED Contractor

SE/C

Ft. from N. Line


330 Ft. from S. Line

330 Ft. from E. Line

Ft. from W. Line

WILDCAT

SECTION PLAT

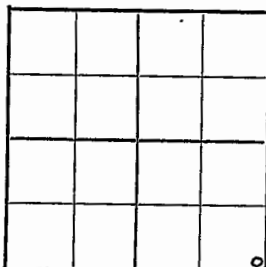

Location

Rig up

Drilling and Remarks:

Loc 8500

5-103554

365 hr to 3504-14

20000000

Pump 2750 ft

240 ft

RECORD

Cased in. ft.

Sand

Gas

Oil

Total Depth *3560*

PRODUCTION

1st 24 hrs. Nat.

1st 24 hrs. after shot

Gas Cu. Ft.

Dry Hole

Abandoned

Date

JUL 21 1943 19

S. J. LEWIS

Scout

Form 26 200 Bks 5-42 Petrol

KANSAS

Ellis

Map No. 70 Sec. 16 Twp. 12 R. 19W

Well No. 1 Galathart

Coralena


Company

FIRST REPORT

Contractor

SE/C

SECTION PLAT

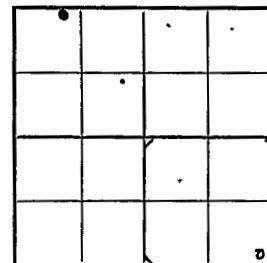

Ft. from N. Line

330 Ft. from S. Line

330 Ft. from E. Line

Ft. from W. Line

WILDCAT

Location

Rig up

Drilling and Remarks:

Rotary

RECORD

Cased in. ft.

Sand

Gas

Oil

Total Depth

PRODUCTION

1st 24 hrs. Nat.

1st 24 hrs. after shot

Gas Cu. Ft.

Dry Hole

Abandoned

Date

JUN 23 1943 19

S. J. LEWIS

Scout

Misc Small Maps.....
 Cards.....
 Tracing.....
 France Map.....
 Scarborough Map.....
 Moody Map.....
 Geological Dept.....
 Moody Flat Book

Misc Small Maps.....
 Cards.....
 Tracing.....
 France Map.....
 Scarborough Map.....
 Moody Map.....
 Geological Dept.....
 Moody Flat Book