


Section 22 Township 12 Range 19-W

Well No. #1 Reeder

Company Coralena

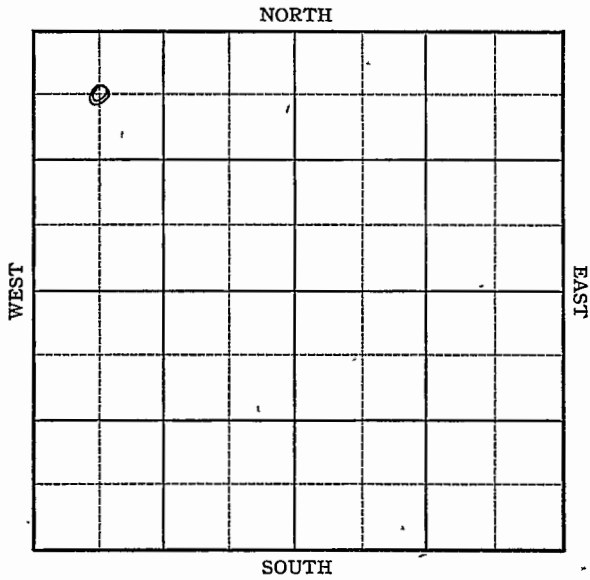

Sec. 22 Twp. 12 R. 19-W

Well No. #1 Reeder Fa

Coralena Compa


660 Ft. from N. Line

\_\_\_\_\_ Ft. from S. Line

\_\_\_\_\_ Ft. from E. Line

660 Ft. from W. Line

Wildcat

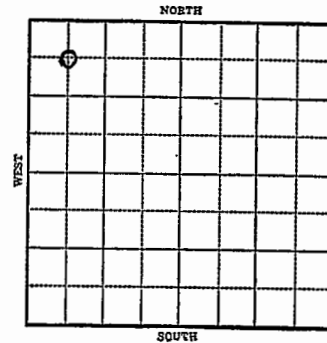

1943 *Elev. 2195* REPORT

7/28	Derrick
8/4	10" @ 125' WOC.
8/11	Anhy 1507 Drlg. 2910'
8/18	Lans 3515 Drlg. 3614'
8/25	Arb 3869 T.D. 3889' 5" @ 3579 Rust.
9/1	"
9/8	"
9/15	34 shots 3522-24 HFW & SD
9/22	Arb 3869 5" @ 3579 HFW T.D. 3889'

**ABANDONED**

**KANSAS**

Map No. 70 Sec. 22 Twp. 12 R. 19W

Well No. 1 Reeder

Coralena Company

ABANDONED Contractor

C NW NW

SECTION PLAT

660 Ft. from N. Line

\_\_\_\_\_ Ft. from S. Line

\_\_\_\_\_ Ft. from E. Line

660 Ft. from W. Line

o			

**Wildcat**

Location \_\_\_\_\_

Rig up \_\_\_\_\_

Drilling and Remarks:

*On 43869*

*5-103579*

*ATW*

**RECORD**

Cased \_\_\_\_\_ in., \_\_\_\_\_ ft.

Sand \_\_\_\_\_

Gas \_\_\_\_\_

Oil \_\_\_\_\_

Total Depth 3889

**PRODUCTION**

1st 24 hrs. Net \_\_\_\_\_

1st 24 hrs. after shot \_\_\_\_\_

Gas \_\_\_\_\_ Cu. Ft.

Dry Hole \_\_\_\_\_

Abandoned \_\_\_\_\_

Date \_\_\_\_\_

SEP 22 1943 19

S. J. LEWIS Scout

**KANSAS**

Map No. 70 Sec. 22 Twp. 12 R. 19W

Well No. 1 Reeder

Coralena Company

FIRST REPORT Contractor

C NW NW

SECTION PLAT

660 Ft. from N. Line

\_\_\_\_\_ Ft. from S. Line

\_\_\_\_\_ Ft. from E. Line

660 Ft. from W. Line

o			

**WILDCAT**

Location \_\_\_\_\_

Rig up \_\_\_\_\_

Drilling and Remarks:

**Derrick**

**RECORD**

Cased \_\_\_\_\_ in., \_\_\_\_\_ ft.

Sand \_\_\_\_\_

Gas \_\_\_\_\_

Oil \_\_\_\_\_

Total Depth \_\_\_\_\_

**PRODUCTION**

1st 24 hrs. Nat. \_\_\_\_\_

1st 24 hrs. after shot \_\_\_\_\_

Gas \_\_\_\_\_ Cu. Ft.

Dry Hole \_\_\_\_\_

Abandoned \_\_\_\_\_

Date \_\_\_\_\_

JUL 28 1943 19

S. J. LEWIS Scout