


Section 27 Township 12 Range 19W

Well No. #1 Dreiling

Company Shelly-Miller

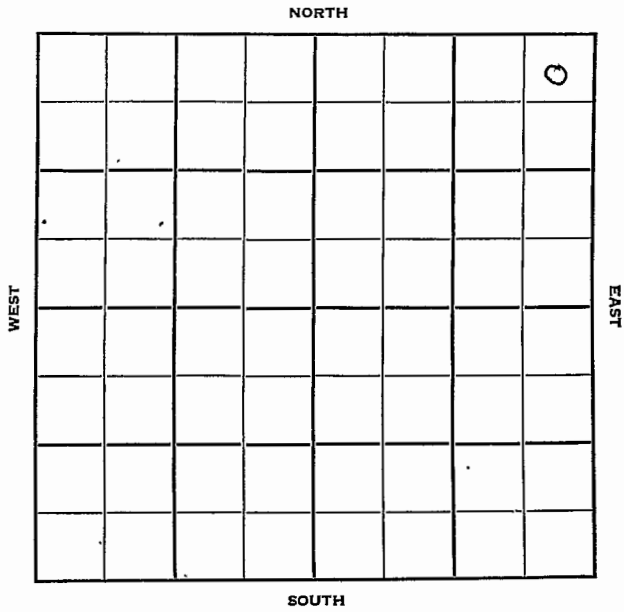

Sec. 27 Twp. 12 R. 19W

Well No. #1 Dreiling Farm _____

Shelly - Miller Company _____

Shelly-Miller Contractor _____

Wildcat

330 Ft. from N. Line


_____ Ft. from S. Line

330 Ft. from E. Line

_____ Ft. from W. Line

NE $\frac{1}{4}$

NE NE NE

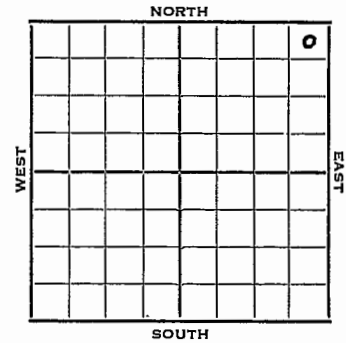

1952 **W**lev. 2166' REPORT

10/22 Spud 10-15-52
8" @ 158'
Anhy 1481'

10/29 Drlg. 2830'
Heeb 3440' Lans. 3485'
DST 3670-3700, 1 hr, 62' OCM 1095#
Cong. 3793' Arb. 3823'

11/5 Spud 10-15-52
D&A TD 3873'
8" @ 158'
Anhy 1481' Heeb. 3440
Lans. 3485
DST 3670-3700 open 1 hr. rec.
62' OCM 1095#
Cong. 3793 Arb. 3823
TD 3873' D&A

ABANDONED

