


Section 19 Township 12 Range 17W

Well No. #1 Pelzl

Company Duke & Wood

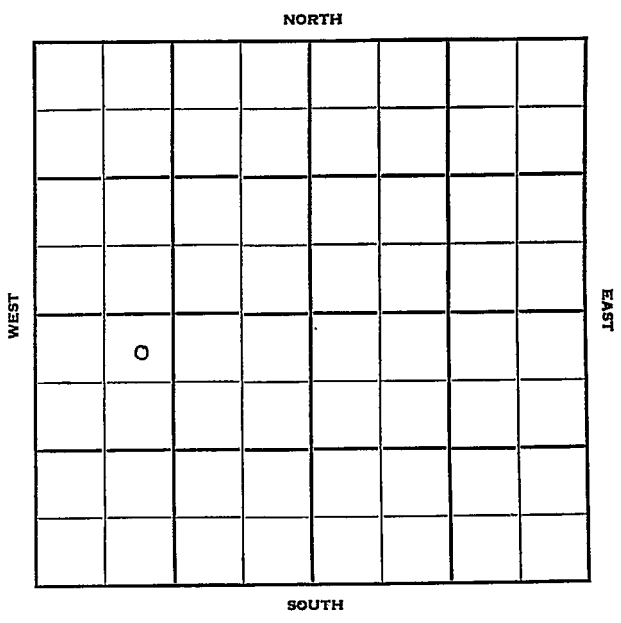

Ellis

KANSAS

Sec. 19 Twp. 12 R. 17 W 1

Well No. # 1 Pelzl Farm

Duke & Wood Company

Contractor

Pleasant Ridge


330 Ft. from N. Line

Ft. from S. Line

Ft. from E. Line

990 Ft. from W. Line

NE NW SW

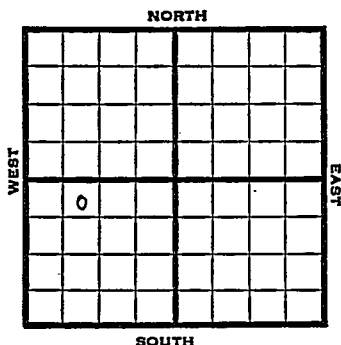

1951 Elev. 2129' REPORT

10/10 RUR
10/24 Spud 10-7-51
D&A TD 3708
8" @ 153'
Anhy 1380' Heeb. 3366
Dodge 3386 Lans. 3412
Cong. 3657
TD 3708
D&A

ABANDONED

Sec. **19** (Blk. Twp.) **12** (Sur. Rge.) **17W** Map No.

Well No. 1 Farm Polzi

FIRST REPORT

Spudding Date _____

RUR

County Ellis State Kansas

Sec. 19 (Blk.) 12 (Sur.) 17W Map No.

Operator Duke & Wood

Well No. 1 Farm Pelzl

Elev.	2129	Location	NE NW SW
-------	------	----------	----------

330 Ft. From N Line SW

990 Ft. From W Line Quarter

Ist. Report

Completion OCT 24 1951

Remarks	Pleasant Ridge
---------	----------------

Spudding Date 10-7-51

Drig. Data D & A TD 3708

8" @ 153 Anhy 1380 Heeb. 3366

Dodge 3386 Lans. 3412 Cong. 3657

TD 3708 D & A

J. E. TYRA