


KANSAS

Ellis

Section 19 Township 12 Range 18-W

Well No. #1 Furthmeyer

Company Anschutz
Wildcat

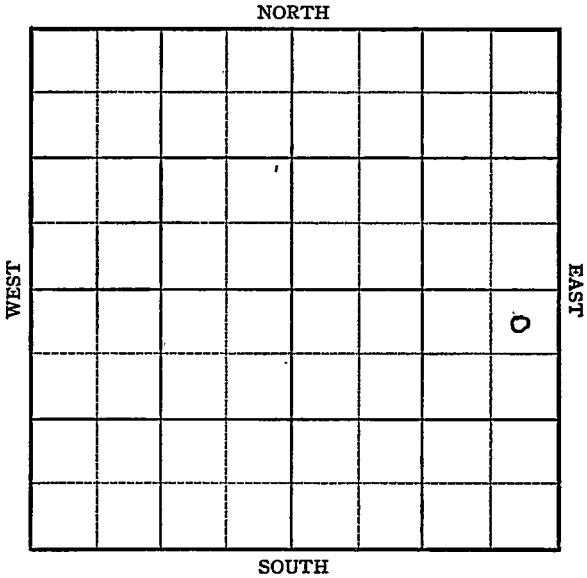

Sec. 19 Twp. 12 R. 18W

Well No. 1 Furthmeyer Farm

Anshutz

Wildcat


Company
Contr. Anschutz
NORTH

330 Ft. from N. Line

_____ Ft. from S. Line

330 Ft. from E. Line

_____ Ft. from W. Line

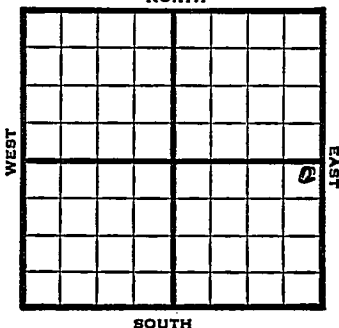

NE SE

1949 Elev. 2177' REPORT

8/24 8" @ 165
Anhy 1465
Drlg 2575

8/31 Lansing 3453'
Drlg. 3802'

9/7 Cong 3745'
TD 3924 in cong.
ABANDONED

Map No. _____ Sec. 19 Twp. 12 R. 18W

Well No. 1 Furthmeyer

Anschutz Company

Anschutz Contractor

**FIRST REPORT
 SECTION PLAT**

NE SE

330 Ft. from N. Line

_____ Ft. from S. Line

330 Ft. from E. Line

_____ Ft. from W. Line

			8"

Ellis County

Location _____

Rig up _____

Drilling and Remarks:

8" @ 165

Anhy 1465

drlg. 2575

RECORD

Cased _____ in. _____ ft.

Sand _____

Gas _____

Oil _____

Total Depth _____

PRODUCTION

1st 24 hrs. Nat. _____

1st 24 hrs. after shot _____

Gas _____ Cu. Ft.

Dry Hole _____

Abandoned _____

Date

AUG 24 1949 19

S. J. LEWIS Scout

Kansas

Map No. K71 Sec. 19 Twp. 12 R. 18WWell No. 1 FurthmeyerAnschutz Company

ABANDONED

Contractor

NE SE

E1,2177
SECTION PLAT330 Ft. from N. Line

Ft. from S. Line

330 Ft. from E. Line

Ft. from W. Line

			o

Ellis County

Location _____

Rig up _____

Drilling and Remarks:

Crng 8745

RECORD

Cased _____ in., _____ ft.

Sand _____

Gas _____

Oil _____

Total Depth 3724 in Crng

PRODUCTION

1st 24 hrs. Nat. _____

1st 24 hrs. after shot _____

Gas _____ Cu. Ft.

Dry Hole _____

Abandoned _____

Date

SEP 7 1949 19

S. J. LEWIS Scout