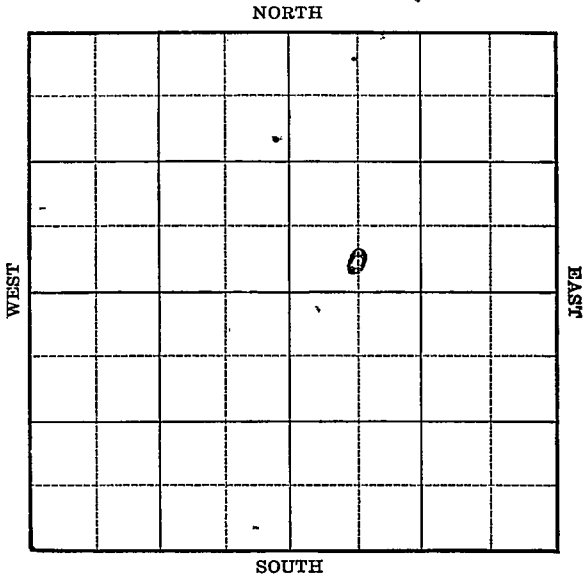


KANSAS

Ellis

Form 51-5M-7-40-Palace

Section 2 Township 12 Range 18-WWell No. #1 ~~Gunther~~ walterCompany Bishop Oil

Map No. 71 Sec. 2 Twp. 12 R. 18WWell No. 1 GuntherBishop Oil Company


Contractor

FIRST REPORT

C S L SW NE

 Ft. from N. Line330 Ft. from S. Line Ft. from E. Line660 Ft. from W. Line

SECTION PLAT

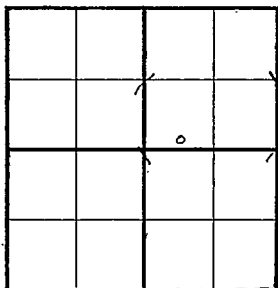

WALTERS POOL

Location Rig up Drilling and Remarks:
Rotary

RECORD

Cased in., ft.Sand Gas Oil Total Depth

PRODUCTION

1st 24 hrs. Nat. 1st 24 hrs. after shot Gas Cu. Ft.Dry Hole Abandoned

Date

SEP 11 1940 19 S. J. LEWIS Scout

Map No. 71 Sec. 2 Twp. 12 R. 18WWell No. 1 WalterBishop Oil CompanyCORRECTION Contractor

C S L SW NE

 Ft. from N. Line330 Ft. from S. Line Ft. from E. Line660 Ft. from W. Line

SECTION PLAT

WALTERS POOL

Location Rig up

Drilling and Remarks:

Reported as

#1 Gunther

RECORD

Cased in., ft.Sand Gas Oil Total Depth

PRODUCTION

1st 24 hrs. Nat. 1st 24 hrs. after shot Gas Cu. Ft.Dry Hole Abandoned

Date

SEP 18 1940₁₉S. J. LEWIS Scout

Map No. 71 Sec. 2 Twp. 12 R. 18WWell No. 1 Walter
Bishop Oil

Company

Contractor

ABANDONED

C S L SW SE

SECTION PLAT

 Ft. from N. Line330 Ft. from S. Line Ft. from E. Line660 Ft. from W. Line

WALTERS POOL

Location Rig up

Drilling and Remarks:

Since 8656
3" C 8708
60 C 8468-8484
Water.

RECORD

Cased in., ft.Sand Gas Oil Total Depth 8710

PRODUCTION

1st 24 hrs. Nat. 1st 24 hrs. after shot Gas Cu. Ft.Dry Hole Abandoned

Date

OCT 23 1940 19S. J. LEWIS Scout