

Ellis

Map No. KANSAS Sec. 2 Twp. 12 R. 18^W

Well No. 1 - Walters Farm
A. G. Reynolds Company

LARIO & WALTERS


NORTH

990 Ft. from N. Line

_____ Ft. from S. Line

330 Ft. from E. Line

_____ Ft. from W. Line

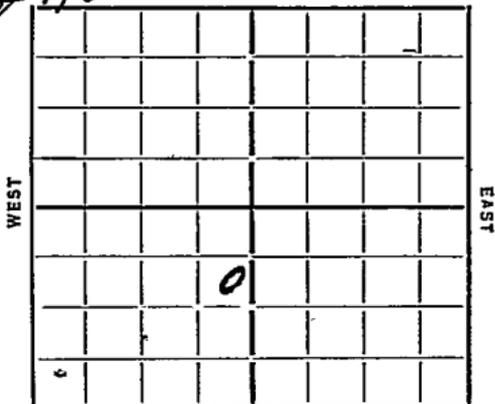

Elev. 2065

REPORT

Date	Event
1935	
8/21	Moving
8/29	9/6 - 10/3 - 10/10 - 11/1
11/14	Rig
11/21	11/29 - 12/6 - 12/13 - 12/19
12/26	1/2/36 - 1/10 - 1/17 - 1/24
1/31	
2/7	Ru
2/14	Spud
2/21	S.D.
2/28	Spud 98
3/6	T.D. 345 S.D.
3/13	Dlg 785
3/20	12" - 1004 Fishing bailer @ 1030
3/27	T.D. 1317 U.R. 12"
4/2	T. Anhy 1314' Drlg. 1325'
4/10	Hole full water 1325' Drlg. 1348'
4/16	Drlg. 2005'
4/23	Drlg. 2503'
4/30	8" @ 2889' Drlg. 2923'

(OVER)

- 5/7- Top-Topeka 3060'. Pay 3063 $\frac{1}{2}$ '
to 65'. T.D. 3000' oil in hole
Under reaming 8" to 3020'.
 - 5/14- 8" @ 3154' Swabbed 33 bbls 1st
hour. 10 bbls in 3 hours and 1
barrell of water.
 - 5/21-Potential 1149 bbls in 24 hrs.
7% BW&S
 - 5/27/36-Top Topeka 3060'
1000 acid.
T.D. 3065'.
Pot. 1159 bbls.
7% BS&W

COMPLETED

Map No. 71 Sec. 2 Twp. 12 R. 18W

Well No. 1 - Walters

P. B. Reynolds Company

Contractor

FIRST REPORTS SECTION PLAT

990 Ft. from N. Line

..... Ft. from S. Line

330 Ft. from E. Line

..... Ft. from W. Line

Location.....

Rig up.....

Drilling and Remarks:

Moving

RECORD

Cased 7 in., ft.

Sand.....

Gas.....

Oil.....

Total Depth.....

PRODUCTION

1st 24 hrs. Nat.....

1st 24 hrs. after shot.....

Gas..... Cu. Ft.

Dry Hole.....

Abandoned.....

Date

ORVAL MANNSCHRECK

8-21-35 192.....

Scout

Map No. 71 Sec. 2 Twp. 12 R. 18W

Well No. 1- Walters

Lario & Walters Company

Contractor

Sec. NE SW

SECTION PLAT

990 Ft. from N. Line

..... Ft. from S. Line

330 Ft. from E. Line

..... Ft. from W. Line

CORRECTION

Location.....

Rig up.....

Drilling and Remarks:

*has been carried
as being drilled
by P. G. Reynolds*

RECORD

Cased.....in.,ft.

Sand.....

Gas.....

Oil.....

Total Depth.....

PRODUCTION

..... 1st 24 hrs. Nat.....

..... 1st 24 hrs. after shot.....

Gas..... Cu. Ft.

Dry Hole.....

Abandoned.....

Date

JAN 8 1936

ORVAL MANNSCHRECK

192.....

Scout

Map No. 71 Sec. 2 Twp. 12 R. 18W

Well No. 1 Shatters

Lariv & Shatters Company

Contractor

SECTION PLAT

		0	

990 Ft. from N. Line

_____ Ft. from S. Line

330 Ft. from E. Line

_____ Ft. from W. Line

COMPLETED

Location _____

Rig up _____

Drilling and Remarks:

Top of ka 3060

1000 acid

Prod 1159 yds.

7% BSW.

RECORD

Cased _____ in., _____ ft.

Sand _____

Gas _____

Oil _____

Total Depth 3065

PRODUCTION

1st 24 hrs. Nat. _____

1st 24 hrs. after shot _____

Gas _____ Cu. Ft.

Dry Hole _____

Abandoned _____

Date

MAY 27 1936₁₉

Scout