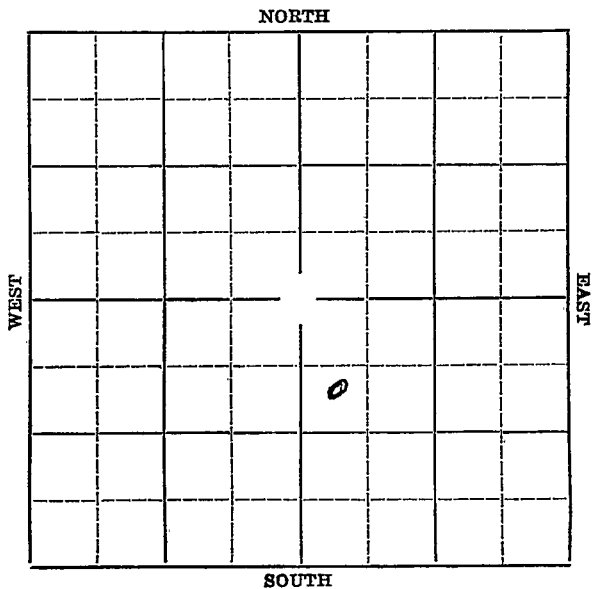
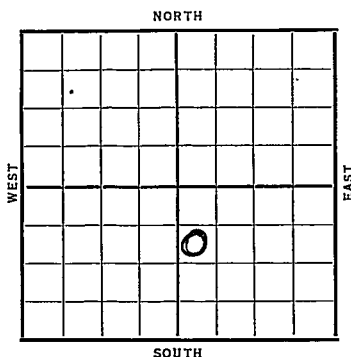


Section 2 Township 12 Range 18-WWell Number #1 WalterCompany Gulf

Sec. 2 Twp. 12 R. 18WWell No. #1 Walter FarmGulf Company990' Ft. from N. Line

Ft. from S. Line

Ft. from E. Line

330' Ft. from W. LineElev 2083

Date	REPORT
1936.	
10/7	Rig.
10/15	--
10/22	Spud.
10/29	15" @ 535'. Drlg. 630'.
11/6	Drlg. 865
11/12	13" @ 1124 Drlg. 1325
11/19	Anhydrate 1340 13" @ 1344 Drlg. 1370'.
11/27	Drlg. 2230'.
12/3	2405' fishing.
12/10	" "
12/17	Run 10" @ 2446'.
12/24	2535' fishing.
12/29	2535' fishing.
1937	
1/7	10" @ 2519'. Drlg. 2850'.
1/14	Underream 8" @ 2935'.
1/21	8" @ 2930'. Ft. Howard 2940'. Topeka 3080'. Show oil 3175-89'. 1 Bailer water 3189-93'. Drlg. 3320'.

OVER

1937

1/28 K C L 3335'. 7" @ 3339'.

Drilg. 3390' no show.

2/4 Simpson 3594 Hole-full-water
3394 Sil 3614 Show oil
TD 3614 Run 5"

2/11 Total Depth 3619 $\frac{1}{2}$ '. 2500' oil in
hole. 26 gravity pull big pipe

2/19 Swabbed 439 bbls oil 13 hr 500'
off bottom 1000 acid. No Test.

2/26 Potential 1563' down 1 $\frac{1}{4}$ hr.
26.4 gravity.

3/3 Sil. 3614'.

T. D. 3619 $\frac{1}{2}$ '.

1000 acid.

Potential 1563 bbls.

26.4 Gravity.

COMPLETED

KANSAS

Map No. 71 Sec. 2 Twp. 12 R. 18W

Well No. 1 Walter

Gulf. Company

Contractor

SECTION PLAT

		00	

990 Ft. from N. Line

_____ Ft. from S. Line

_____ Ft. from E. Line

330 Ft. from W. Line

FIRST REPORT

Location _____

Rig up _____

Drilling and Remarks:

Rig

RECORD

Cased _____ in., _____ ft.

Sand _____

Gas _____

Oil _____

Total Depth _____

PRODUCTION

1st 24 hrs. Nat. _____

1st 24 hrs. after shot _____

Gas _____ Cu. Ft.

Dry Hole _____

Abandoned _____

Date

OCT 7 1936

19

S. J. LEWIS

Scout

Map No. 71 Sec. 2 Twp. 12 R. 18WWell No. 1 WalterCompany Gulf.

Contractor _____

SECTION PLAT

		0	

990 Ft. from N. Line

_____ Ft. from S. Line

_____ Ft. from E. Line

330 Ft. from W. Line

COMPLETED

Location _____

Rig up _____

Drilling and Remarks:

Sil 3614
1000 acid
Potential
1563 lbs.
26.4 gravity

RECORD

Cased _____ in., _____ ft.

Sand _____

Gas _____

Oil _____

Total Depth 3619 1/2

PRODUCTION

1st 24 hrs. Nat. _____

1st 24 hrs. after shot _____

Gas _____ Cu. Ft.

Dry Hole _____

Abandoned _____

Date

MAR 3 1937

S. J. LEWIS

Scout