


Section 2 Township 12 Range 18W

Well No. #4 Walter "B"

Company Lario O. & Gas

Walters

NORTH

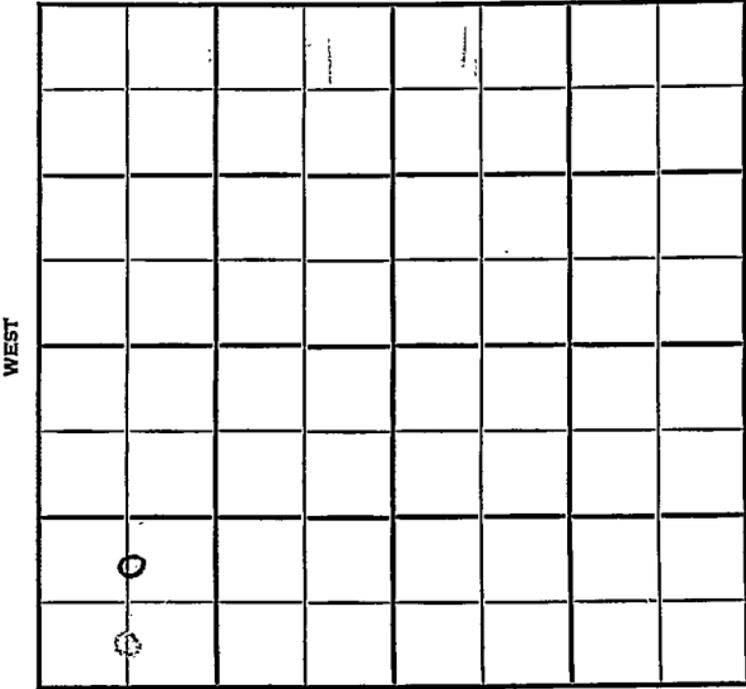


SOUTH

Sec. 2 **KANSAS** Twp. 12 R. 18W

Well No. #4 Walter "B" Farm  
Lario O. & Gas Company

**Walters**  
\_\_\_\_\_ Ft. from N. Line  
990 Ft. from S. Line  
\_\_\_\_\_ Ft. from E. Line  
660 Ft. from W. Line  
**C N L SW SW**

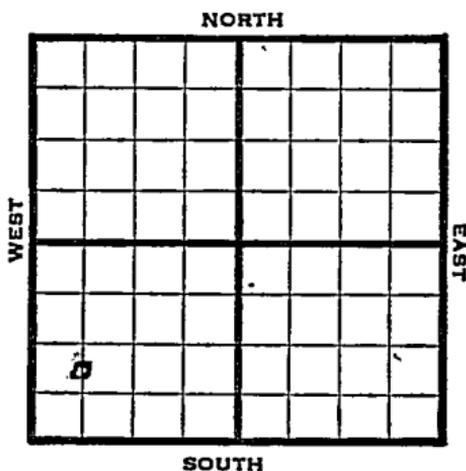

1947 Elev. 2110' REPORT

10/22 220'

10/29 8" @ 1369'  
Drlg. 2604'

11/5 Topeka 3050'  
Heebner 3299'  
Lansing 3877'  
TD 3698'  
SO  
Running csg.

11/12 5" @ 3698'  
32 shots 3623-33' - 500 acid  
Swabb 5 oil PH

11/19 "

11/25 "

12/3 Arbuckle 3624'  
5" @ 3695'  
Perf.  
Acid 500  
Pump 146 oil & 48% W Pot.  
Gr. 270  
Total Depth 3698'

**COMPLETED**

Walters

Map No. \_\_\_\_\_ Sec. 2 Twp 12 R. 18W

Well No 4 Walter "B"

Lario O. & Gas Company

**FIRST REPORT** Contractor

C N L SW SW

**SECTION PLAT**


\_\_\_\_\_ Ft. from N. Line

990 Ft. from S. Line

\_\_\_\_\_ Ft. from E. Line

660 Ft. from W. Line

Ellis County

**RECORD**

Location \_\_\_\_\_

Cased \_\_\_\_\_ in., \_\_\_\_\_ ft.

Rig up \_\_\_\_\_

Sand \_\_\_\_\_

Drilling and Remarks:

Gas \_\_\_\_\_

220'

Oil \_\_\_\_\_

Total Depth \_\_\_\_\_

**PRODUCTION**

1st 24 hrs. Nat. \_\_\_\_\_

1st 24 hrs. after shot \_\_\_\_\_

Gas \_\_\_\_\_ Cu. Ft.

Dry Hole \_\_\_\_\_

Abandoned \_\_\_\_\_

Date

OCT 22 1947 19

S. J. LEWIS

Scout

