


Section 2 Township 12 Range 18-W

Well Number 2 Walter "C"

Company Lario

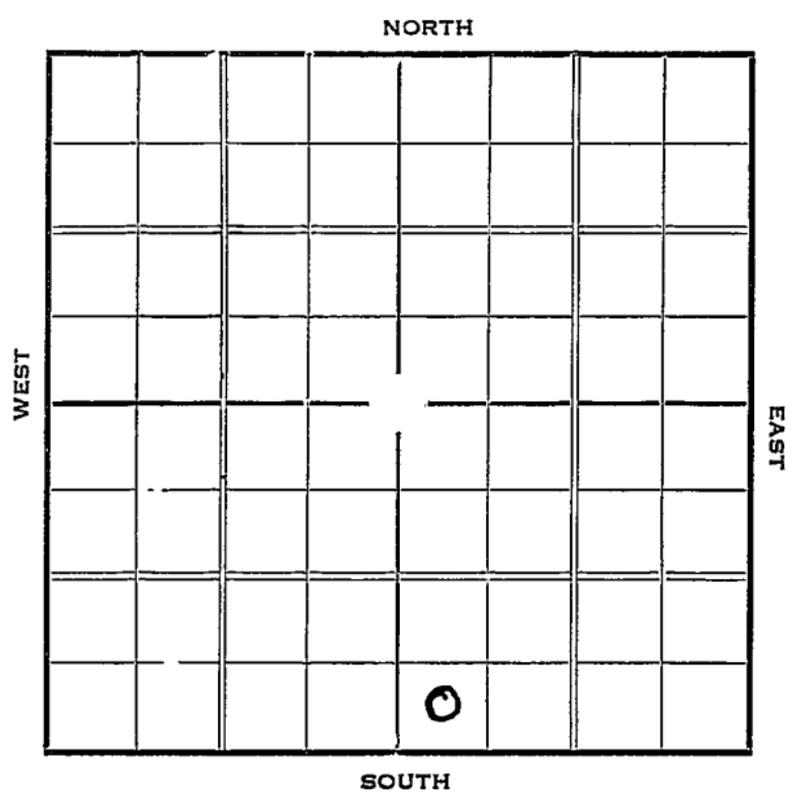

Sec. 2 Twp. 12 R. 18-W

Well No. #2 Walter "C" Farm

Lario Company


 Ft. from N. Line

330 Ft. from S. Line

 Ft. from E. Line

330 Ft. from W. Line

Elev. 2114

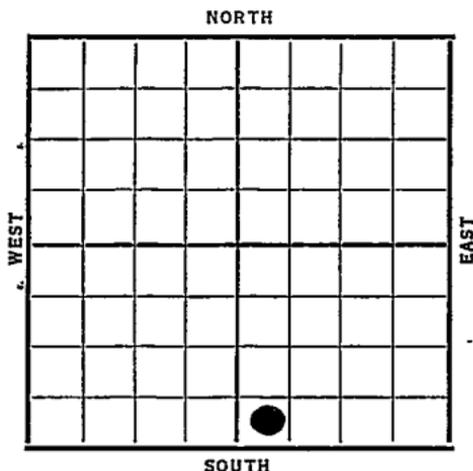

Date	REPORT
1937	
3/31	R O G
4/8	Rig
4/16	Rig
4/23	"
4/30	"
5/7	"
5/14	"
5/21	Anhy 1068'. 15" @ 1072'.
	Drlg. 1946'.
5/28	Drlg. 2910'.
6/4	Sil. 3635'8 T.D. 3637'.
	Sat. core. Rn'G 7".
6/11	7" @ 3635'. T.D. 3637'.
6/19	T.D. 3643'. 3000' oil.

OVER

1937

6/23 7" @ 3635'.

Sil. 3635'.

T.D. 3643'.

Pot. 1424 bbls. Nat.

COMPLETED

Map No. _____ Sec. 2 Twp. 12 R. 18W

Well No. 2 Walter "C"

Lario Company

Contractor

SECTION PLAT

_____ Ft. from N. Line

330 Ft. from S. Line

_____ Ft. from E. Line

330 Ft. from W. Line

FIRST REPORT

Location _____

Rig up _____

Drilling and Remarks:

ROG

RECORD

Cased _____ in., _____ ft.

Sand _____

Gas _____

Oil _____

Total Depth _____

PRODUCTION

1st 24 hrs. Nat. _____

1st 24 hrs. after shot _____

Gas _____ Cu. Ft.

Dry Hole _____

Abandoned _____

Date

MAR 31 1937

19

S. J. LEWIS

Scout

Ellis KANSAS

Map No. 71 Sec. 2 Twp. 12 R. 18^w

Well No. 2-Walter "C"

Lario Company

Contractor

COMPLETED

SECTION PLAT

_____ Ft. from N. Line

330 Ft. from S. Line

_____ Ft. from E. Line

330 Ft. from W. Line

		0	

Location _____

Rig up _____

Drilling and Remarks:

Pat - 1424
NAT.

RECORD

Cased 7 in., 3635 ft.

Sand 511 3635

Gas _____

Oil _____

Total Depth 3643

PRODUCTION

1st 24 hrs. Nat. _____

1st 24 hrs. after shot _____

Gas _____ Cu. Ft.

Dry Hole _____

Abandoned _____

Date

JUN 23 1937 19

H. D. Hatfield Scout