


Section 2 Township 12 Range 18W

Well No. #1 Walters

Company Prime Drlg.

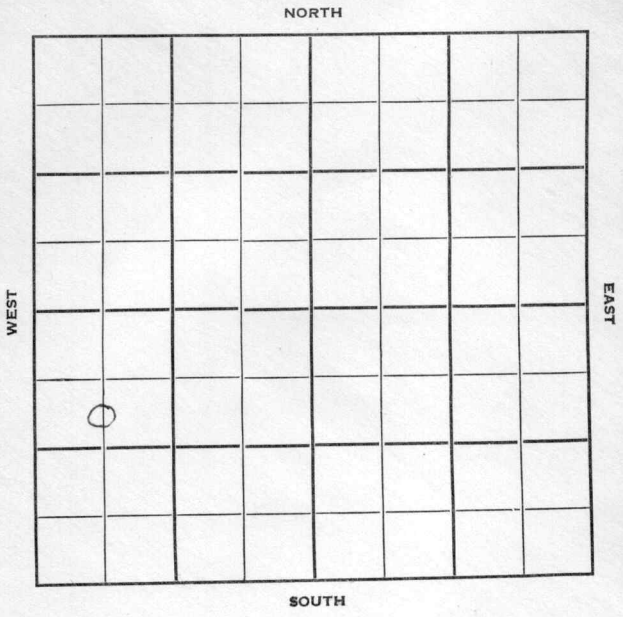

Sec. 2 Twp. 12 R. 18W

Well No. #1 Walters Farm

Prime Drlg. Company

Contractor

Walters Pool


990' Ft. from N. Line

\_\_\_\_\_ Ft. from S. Line

\_\_\_\_\_ Ft. from E. Line

660' Ft. from W. Line

C S L NW SW

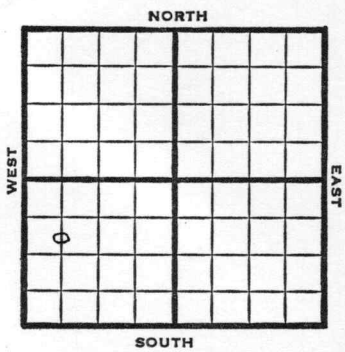

1950

Elev 2112' REPORT

1/25

Spud 1-23-50  
Drlg.

3/15

TD 4186'  
8"@ 215'  
5"@ 3795'  
Arb. 3667'  
Input 400 bbls salt wtr pr hr  
Salt wtr Disposal  
Aband.

**ABANDONED**

Kansas

Walters Pool

Map No. \_\_\_\_\_ Sec. 2 Twp. 12 R. 18W

Well No. 1 Walters

Prime Drlg.

Company \_\_\_\_\_

Contractor \_\_\_\_\_

C S L NW SW

SECTION PLAT

990 Ft. from N. Line

\_\_\_\_\_ Ft. from S. Line

630 Ft. from E. Line

660 Ft. from W. Line



Ellis County

RECORD

Location \_\_\_\_\_

Cased \_\_\_\_\_ in., \_\_\_\_\_ ft.

Rig up \_\_\_\_\_

Sand \_\_\_\_\_

Drilling and Remarks:

Gas \_\_\_\_\_

Spud 1-23-50

Oil \_\_\_\_\_

drlg.

Total Depth \_\_\_\_\_

PRODUCTION

1st 24 hrs. Nat. \_\_\_\_\_

1st 24 hrs. after shot \_\_\_\_\_

Gas \_\_\_\_\_ Cu. Ft.

Dry Hole \_\_\_\_\_

Abandoned \_\_\_\_\_

Date

JAN 25 1950 19

J. E. TYRA

Scout

Kansas

Map No. \_\_\_\_\_ Sec. 2 Twp. 12 R. 18W

Well No. 1 Walters

\_\_\_\_\_ Prime Drlg. \_\_\_\_\_ Company

\_\_\_\_\_ Contractor

C S L NW SW

*E. 2112*  
SECTION PLAT

990 Ft. from N. Line

\_\_\_\_\_ Ft. from S. Line

\_\_\_\_\_ Ft. from E. Line

660 Ft. from W. Line

	COMPLETE		
o			

Ellis County

Location \_\_\_\_\_

Rig up \_\_\_\_\_

Drilling and Remarks:

*8 @ 215*  
*5" @ 3795*  
*arb 3667*  
*Input 400 Bbls*  
*Salt water per hr.*  
*Salt Water*

RECORD

Cased \_\_\_\_\_ in., \_\_\_\_\_ ft.

Sand \_\_\_\_\_

Gas \_\_\_\_\_

Oil \_\_\_\_\_

Total Depth 4186

PRODUCTION

1st 24 hrs. Nat. \_\_\_\_\_

1st 24 hrs. after shot \_\_\_\_\_

Gas \_\_\_\_\_ Cu. Ft.

Dry Hole \_\_\_\_\_

Abandoned \_\_\_\_\_

Date *Disposal*

MAR 15 1950 19

J. E. TYRA

Scout