

Section 2 Township 12 Range 18 WWell No. # 2 Walters "D"Company Lario Oil & Gas

NORTH

							0

WEST

EAST

SOUTH

Ellis

KANSAS

Sec. 2 Twp. 12 R. 18W

Well No. #2 Walters "D" Farm

Lario Oil & Gas Company

Sterling Drlg. -Contr. Contractor

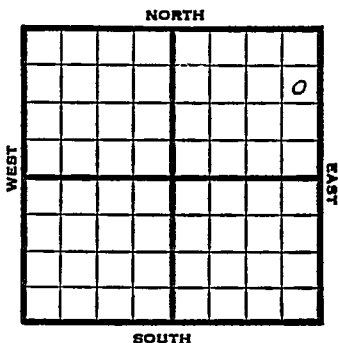
Walters Pool

990' Ft. from N. Line

 Ft. from S. Line

330' Ft. from E. Line

 Ft. from W. Line



SE NE NE

1951

Elev. 2081'

REPORT

3/7

RUR

4/11

Spud 3-18-51

D & A TD 3642'

8" @ 1344' Anhy 1334' Top. 3049',

Heeb 3295', Lans 3339', Simp 3598',

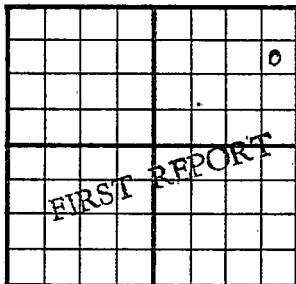
DST 3612-30 open 1 hr. rec 15' mud

Arb. 3631'

DST 3632-38' open 1 hr. rec 25' OCM

TD 3642' D & A

ABANDONED

County Ellis State KansasSec. 2 (Blk.) 12 (Sur.) 18W Map No.Operator Lario Oil & GasWell No. 2 Farm Walters "D"Elev. Location SE NE NE990 Ft. From N Line NE330 Ft. From E Line Quarter1st. Report MAR 7 1961

Completion

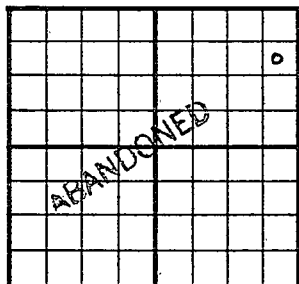
Remarks

Sterling Drlg. - Contr.

Spudding Date

Drlg. Data Walters PoolR U R

J. E. TYRA

County Ellis State KansasSec. 2 (Blk. Twp.) 12 (Sur. Rge.) 18W Map No. _____Operator Lario Oil & GasWell No. 2 Farm Walters "D"Elev. 2081 Location SE NE NE990 Ft. From N Line NE330 Ft. From E Line Quarter

1st. Report _____

Completion APR 11 1951Remarks Walters PoolSterling Drlg. - Contr.Spudding Date 3-18-51Drlg. Data D & A TD 36428" @ 1344 Anhy 1334 Top. 3049Heeb. 3295 Lans. 3339 Simp. 3598DST 3612-30 open 1 hr. Rec. 15' mudArb. 3631 DST 3632-38 open 1 hr.Rec. 25' ocm TD 3642D & A

J. E. TYRA