


Section 20 Township 12 Range 17W

Well No. #1 Karlin

Company Harms & Knight

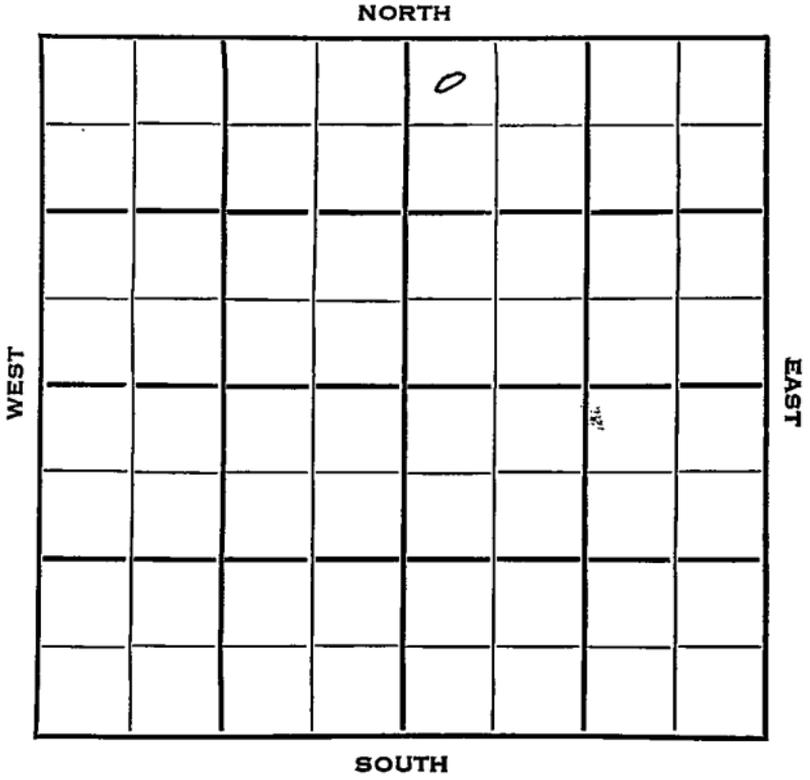

Sec. 20 Twp. 12 R. 17 W

Well No. # 1 Karlin Farm

Harms & Knight Company

Harms & Knight Contractor

Wildcat

330 Ft. from N. Line


Ft. from S. Line

Ft. from E. Line

330 Ft. from W. Line

NW NW NE

NCRA - DHM

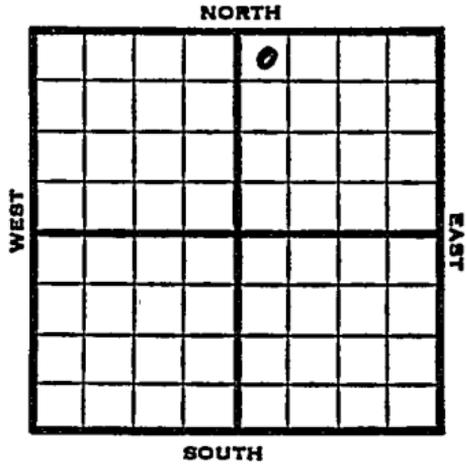

1953 Elev. 2166' REPORT

2/11 Location
 2/19 "
 2/26 8" @ 158 w/100
 Anhy 1386'
 Drlg. 2886'
 3/11 Spud 2-17-53 D & A TD 3875
 8" @ 158 Anhy 1386 Heeb 3381
 Lans. 3425
 DST 3494-3533 open 1 hr. rec 15' mud
 410#
 DST 3590-3602 open 1 hr. rec 20' SOCM
 O# TD 3875 Cong 3679
 D & A

ABANDONED

