

KANSAS

Ellis


Sec. 20 Twp. 12 R. 17W

Well No. #1 Karlin Farm

C & G Drlg. Company

SW NE

NORTH

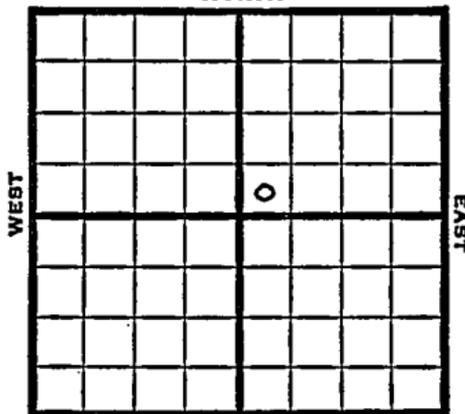

_____ Ft. from N. Line

330'

_____ Ft. from S. Line

_____ Ft. from E. Line

330'

_____ Ft. from W. Line

SW NE

SOUTH

1949

Elev 2152' REPORT

- 5/4 Location
- 5/10 RUR
- 5/18 8" @ 242'
Drlg 2270'
- 5/25 Lans. 3420'
Drlg 3650'
- 6/1 Arb. 3712-17'
TD 3717'
5" @ 3714'
- 6/8 Arb. 3712'
5 @ 3714'
TD 3730'
1500 Acid wtr.
Aband.

ABANDONED

Map No. _____ Sec. 20 Twp. 12 R. 17W

Well No. 1 Karlin


C & G Drlg. Company

FIRST REPORT

Contractor

SW NE

SECTION PLAT

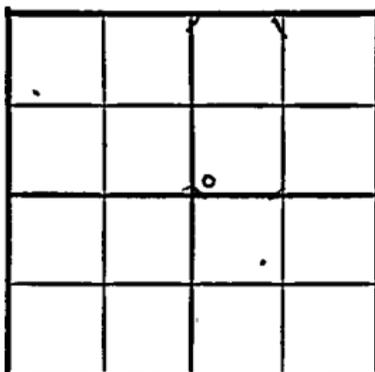

_____ Ft. from N. Line

330 Ft. from S. Line

_____ Ft. from E. Line

330 Ft. from W. Line

Ellis County

Location X

Rig up _____

Drilling and Remarks:

RECORD

Cased _____ in., _____ ft.

Sand _____

Gas _____

Oil _____

Total Depth _____

PRODUCTION

1st 24 hrs. Nat. _____

1st 24 hrs. after shot _____

Gas _____ Cu. Ft.

Dry Hole _____

Abandoned _____

Date

MAY 4 1949 19

S. J. LEWIS Scout

Ellis County Kansas State

Map No. K 71 Sec. 20 Twp. 12 R. 17W

Well No. 1 Karlin

C & G Drlg. Company

ABANDONED

Contractor

SW NE

E 12152

SECTION PLAT

 Ft. from N. Line

330 Ft. from S. Line

 Ft. from E. Line

330 Ft. from W. Line

Wildcat.

Remarks:

Dr 83712
5" C 3714
7173730
1500 acid water

Date JUN 8 1949

Scout S. J. LEWIS