


Section 21 Township 12 Range 17W

Well No. #1 Dreiling

Company Carl Lebsack

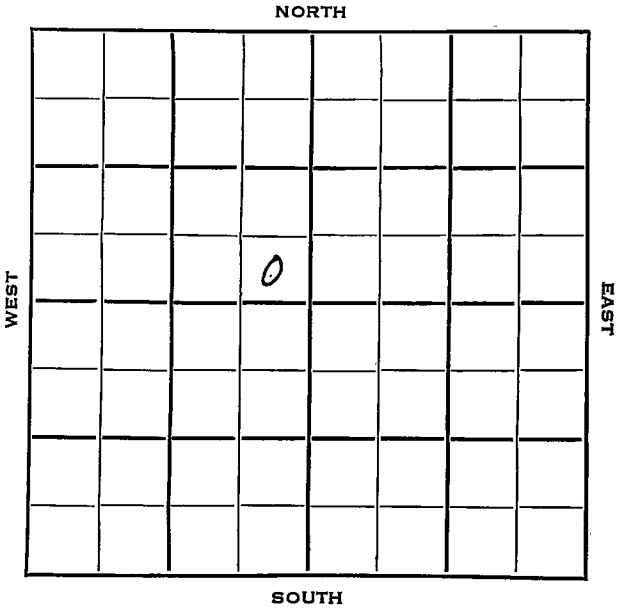

Sec. 21 Twp. Ellis 12 R. KANSAS 17W

Well No. #1 Dreiling Farm

Garl Lebsack Company

Glenn Nye- Contractor
Pleasant Ridge


 Ft. from N. Line

330 Ft. from S. Line

330 Ft. from E. Line

 Ft. from W. Line

SE SE NW

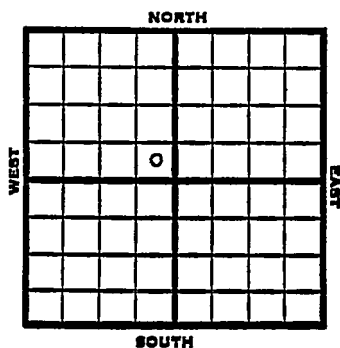

1953

Elev. 2124'

REPORT

7/8

Spud 7-3-53
8" @ 152
Drlg. 2400'


7/22

NR

9/16

Spud 7-3-53 Oil well TD 3700
8" @ 152 Anhy 1330' Top 3106
Heeb 3343 Tor. 3367 Lans 3387
DST 3546-73 open 3/4 hr. rec 315'
VHO & GCM 1050# Cong 3641
Simp. 3680 Arb. 3691 TD 3700
5" @ 3693 CO to 3700 10 GPH
500 A B/1/2 BOPH 5 hr. 250 A
B/2 BOPH 5 hr. 750 A S/1 1/2 BOPH
PB 3590 18/3540-46 3 BOPH 4 hr.
500 A S/13 1/2 BOPH P/8 BOPH
Comp. 215 BOPD

COMPLETED

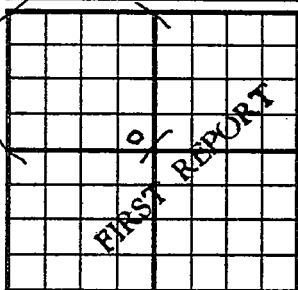
County Ellis State KansasSec. 21 (Blk.
Twp.) 12 (Sur.
Rge.) 17W Map No.Operator Carl LebsackWell No. 1 Farm DreilingElev. Location SE SE NW330 Ft. From S Line NW330 Ft. From E Line Quarter1st. Report JUL 8 1953

Completion

Remarks

Glenn Nye-Contr.Spudding Date 7-3-53Drlg. Data Pleasant Ridge8" @ 152 Drlg. 2400J. G. McGEHEE

County Ellis State Kansas
 Sec. 21 (Blk. Twp.) 12 (Sur. Rge.) 17W Map No. _____
 Operator Carl Lebsack
 Well No. 1 Farm Dreiling
 Elev. 2124 Location SE SE NW

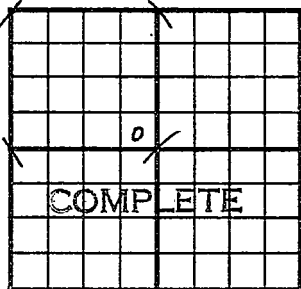

330 Ft. From S Line NW
330 Ft. From E Line Quarter

1st. Report

Completion SEP 16 1953

Remarks Pleasant Ridge Pool
Glenn Nye - Contr.

Spudding Date 7-3-53

Drlg. Data Oil well TD 3700

8" @ 152 Anhy 1330 Top. 3106

Heeb. 3343 Tor. 3367 Lans. 3387

DST 3546-73 open 3/4 hr. Rec. 315'

who & gcm 1050# Cong. 3641

Simp. 3680 Arb. 3691 TD 3700 5" @

3693 CO to 3700 10 goph 500 A

B/ 1/2 boph 5 hr. 250 A B/ 2 boph 5 hr

750 A S/ 1 1/2 boph PB 3590 18/ 3540-46

3 boph 4 hr. 500 A S/ 13 1/2 boph

P/ 8 boph Comp. 215 bopd

J. G. McGEHEE