


Ellis

KANSAS

Section 21 Township 12 Range 18W

Well No. #1 Madden

Company Trans-Era

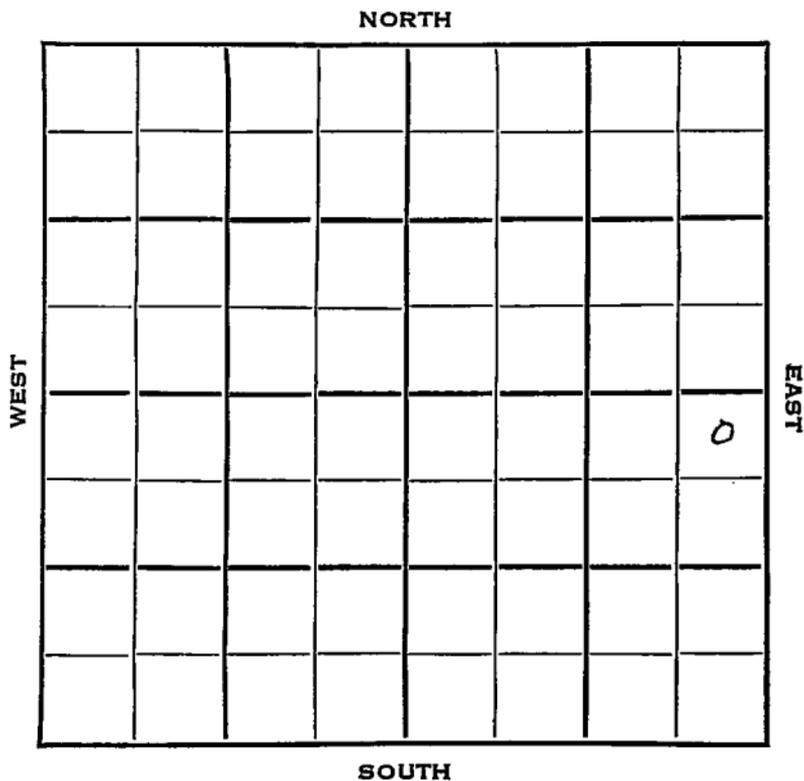

Ellis

KANSAS



Sec. 21 Twp. 12 R. 18 W

Well No. # 1 Madden Farm

Trans-Era Company

Trans-Era Contractor


Semi-Wildcat

330 Ft. from N. Line

_____ Ft. from S. Line

330 Ft. from E. Line

_____ Ft. from W. Line

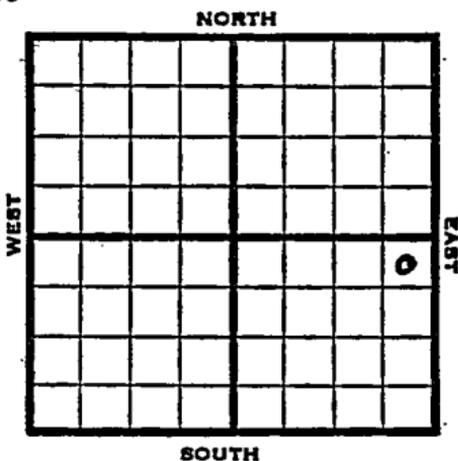

NE NE SE
Derby \$2500.00

1953 Elev. 2129' REPORT

2/18 MIR

2/26 8" @ 191 w/135
Drlg. 1125'

3/11 Spud 2-21-53
D & A TD 3740 8" @ 191
Heeb 3363 Lans 3409 B KC 3640
Cong. 3666 Simp sh 3686'
Simp dol. 3704 Arb. 3710
TD 3740 D & A

ABANDONED

