

Section 21 Township 12 Range 18W

Well No. #1 Schumaker

Company E.F. Wakefield

NORTH

0							

WEST

EAST

SOUTH

Ellis

KANSAS

Sec. 21 Twp. 12 R. 18W

Well No. #1 Schumaker Farm

E. F. Wakefield Company

Wakefield Contractor
Wildcat


Ft. from N. Line

330 Ft. from S. Line

Ft. from E. Line

330 Ft. from W. Line

SW SW SW
Shell-FO \$4000. DHM

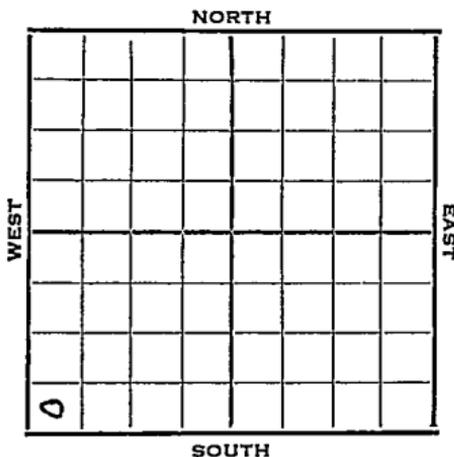

1952 Elev. 2177' REPORT

2/27 RUR
 3/5 8" @ 155'
 Anhy 1460'
 Drlg. 3072'

3/12 Spud 2-27-52
 D&A TD 3810
 8" @ 155'
 Anhy 1460 Top. 3183
 Heeb. 3422 Lans. 3460
 Cong. 3738
 DST 3750-56 open 1 hr. rec. 6' mud
 DST 3743 failed
 Arb. 3750 TD 3810
 D&A

ABANDONED

