


**WELL LOG BUREAU—KANSAS GEOLOGICAL SOCIETY**  
**508 East Murdock, Wichita, Kansas**

Company- **PYRAMID DRILLING CO.**  
 Farm- **Schoenthaler No. 7**

SEC. **26 T. 12 R. 22W**  
**SW NW SE**

Total Depth. **3972**  
 Comm. **11-12-53** Comp. **11-27-53**  
 Shot or Treated.  
 Contractor. **Trans Era Petroleum, Inc.**  
 Issued. **2-13-54**

County **Trego**  
**KANSAS**

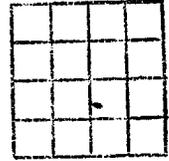

Elevation. **2315'**

Production. **174 Bbls.**

**CASING:**

**8 5/8" 251' com. w/175 sx**  
**5 1/2" 3968' com. w/150 sx**

Figures indicate Bottom of Formations

shale & shells	520
shale & limo	583
shale	930
sand	980
red bed & shale	1140
sand & shale	1450
red bed & shale	1720
anhydrite & shale	1760
shale	2022
shale & shells	2500
shale & lime	2935
shale	2981
shale & lime	3525
lime	3554
lime & shale	3626
lime	3809
lime & shale	3921
shale, lime, chert	3945
lime & chert	3972
Total Depth	

**TOPS: (Scout)**

Topoka	3347
Lansing	3580
Base Kansas City	3829
Arbuckle	3965

Trego

KANSAS

SEC.	TWP.	R.
26	12	22W

WELL NO.

#7 Schoenthaler

FARM

COMPANY

T.L. Ferrier

CONTRACTOR

Trans-Era


Ogallah Pool

990 Ft. from N. Line

Ft. from S. Line

Ft. from E. Line

330 Ft. from W. Line

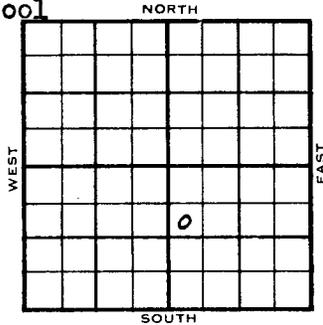

SW NW SE

	ELEVATION	REPORT
1953	2315'	
11/18	Spud 11-12-53 8" @ 251' Anhy 1720' Drlg 2300'	
12/9	Arb. 3965' RTD 3972' 5" @ 3967 DD 3989 FU 2000' oil	
12/16	FU 3200' oil	
1954		
1/27	Spud 11-12-53 Oil well TD 3991 8" @ 251' Anhy 1720' Top 3347' Heeb 3547' Lans 3580' B KC 3829 Arb. 3965' TD 3972' 5" @ 3967 DD 3989 FU 2000' oil DD 3991 FU 3200' oil Comp. 174 BOPD	
		<b>COMPLETED</b>