


WELL LOG BUREAU—KANSAS GEOLOGICAL SOCIETY  
508 East Murdock, Wichita, Kansas

Company- STANOLIND OIL & GAS CO.  
Farm- E. A. Scott No. 3

SEC. 26 T. 12 R. 22W  
SE SW SW  
330' N of SL, 990' E. of WL  
SW/4

County Trego  
KANSAS

Total Depth. 4004'  
Comm. 12-20-55 Comp. 2-22-56  
Shot or Treated.  
Contractor.  
Issued. 4-7-56

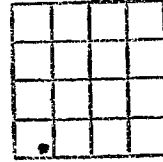

CASING:

8 5/8" 202' cem w/150 sx  
5 1/2" 4000' cem w/860 sx

Elevation. ~~2336'~~ Gr.

Production. 162.69 BO

Figures Indicate Bottom of Formations.

sand	110
sandy shale	160
shale	202
shale & shells	826
shale, clay & shells	950
sand	1400
shale & sand streaks	1560
shale, sand & red bed	1740
anhydrite	1775
shale	1780
shale & shells	2040
shale	2068
shale & lime streaks	2300
shale & lime	2460
lime & shale	2665
shale & lime	2690
lime & shale	3950
shale & lime	3999
Arbuckle	3404
Total Depth	

Tops:  
Lansing 3596  
Arbuckle 3999

Trego

KANSAS

SEC. 26	TWP. 12	R. 22W
------------	------------	-----------

WELL NO. #3 Edna Alice Scott FARM

COMPANY Stanolind

CONTRACTOR Transit

Ugallah


\_\_\_\_\_ Ft. from N. Line

\_\_\_\_\_ Ft. from S. Line

\_\_\_\_\_ Ft. from E. Line

\_\_\_\_\_ Ft. from W. Line

# SE SW SW

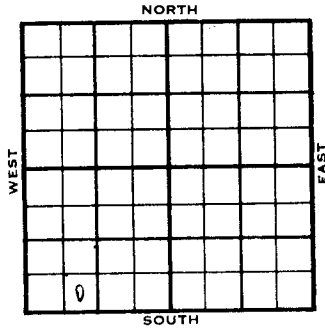

	ELEVATION	REPORT
1955		
12-21	Location	