

**WELL LOG BUREAU—KANSAS GEOLOGICAL SOCIETY**  
**508 East Murdock, Wichita, Kansas**


Company- THE TEXAS COMPANY  
 Farm- J. F. Steckline No. 3

SEC. 26 T. 12 R. 22W  
 SE SW NW

Total Depth. 4051'  
 Comm. 3-16-56 Comp. 4-7-56  
 Shot or Treated.  
 Contractor. Transit Corp.  
 Issued. 6-23-56

County Trego

KANSAS

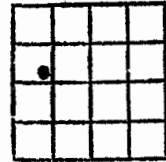

**CASING:**

10 3/4" 271' cem w/180 sx  
 7" 4036' cem w/175 sx

Elevation. 2349' DE

Production. 49 BO, NW in 24 hrs.

Figures indicate Bottom of Formations.

surface clay & sand	40
shale & shells	890
sand	1080
shale	1100
shale & shells	1320
sand	1475
shale	1725
red bed & shale	1760
anhydrite	1808
shale & shells	2330
shale & lime	2710
shale & shells	2855
shale	2980
shale & lime	3720
lime	3792
lime & shale	4034
lime Core	4051
Total Depth	

Tops:

Cimarron Dolomite	1753
Topeka	3399
Heebner	3596
Lansing	3629
Base Kansas City	3870
Simpson	4007
Arbuckle	4034

Trego

KANSAS

SEC. 26	TWP. 12	R. 22W
------------	------------	-----------

WELL NO.

#3 J.S. Steckline

FARM

COMPANY

Texas Company

CONTRACTOR

Transit


Ogallah

\_\_\_\_\_ Ft. from N. Line

\_\_\_\_\_ Ft. from S. Line

\_\_\_\_\_ Ft. from E. Line

\_\_\_\_\_ Ft. from W. Line

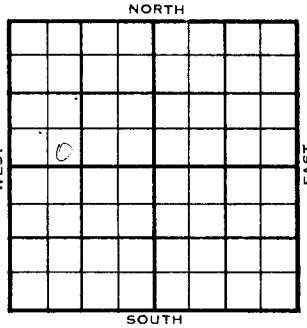

SE SW NW

	ELEVATION	REPORT
1956	2349 DF,	
3-21	Comm. 3-16-56 10" @ 279/180 Drlg. 2050	
4-25	DST 4037-51 op 1 hr. rec. 70' GIP, 290' hocm, 860/20" 7" @ 4036/175 CO to 4061, 11½ bo, 5 hrs., 100 A S/ 9¼ bo, 5 hrs., 500 A P/ 20 bo, 8 hrs. Comp. 49 bopd. A. 4033 4030 Log tops: H. 3596 L. 3629 BKC 3870 TD 4051'	
		<b>COMPLETED</b>